


KANSAS

Butler County

Section 21 Township 27 Range 6E

Well No. #1 Sontag

Company H. & M. Drlg.

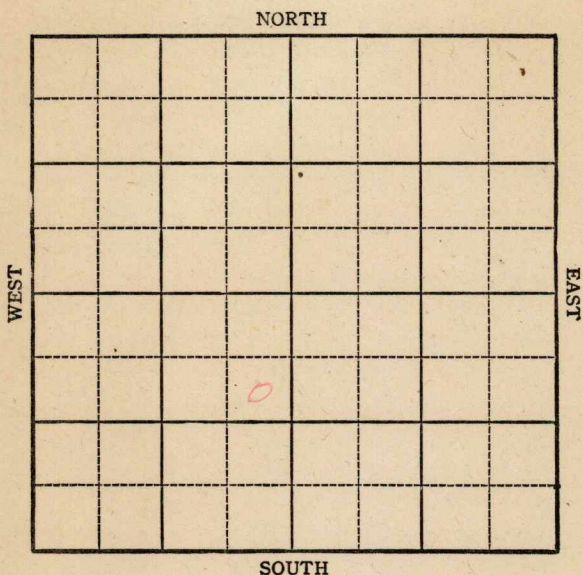

Butler County

KANSAS

Sec. 21 Twp. 27 R. 6E

Well No. #1 Sontag Farm

H. & M. Drlg. Company

Miscellaneous

990 Ft. from N. Line


 Ft. from S. Line

330 Ft. from E. Line

 Ft. from W. Line

SE NE SW

Elev. 1317

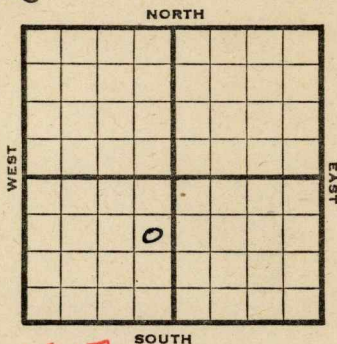

1944

R E P O R T

10/4 Location

10/11 Cable rig

10/18 " "

10/25 12" @ 640 Drlg. 1690

11/1 **Lans. 1716**

10" @ 1725

Drlg. 1955

11/8 **KC 2050**

Drlg. 2325

11/16 **Miss 2700**

8" @ 2700'

Drlg. 2717'

11/24 SD

11/29 "

12/6 "

12/14 "

12/20 **Viola 3012**

6" @ 2998'

TD 3014

Pump 35 Pot.

COMPLETED

KANSAS

Pool Name MiscellaneousMap No. 11 Sec. 21 Twp. 27 R. 6EWell No. 1 SontagH. & M. Drlg. CompanyFIRST REPORT Contractor

SE NE SW

SECTION PLAT

990 Ft. from N. Line Ft. from S. Line330 Ft. from E. Line Ft. from W. Line

		0	

ButlerLocation XRig up

Drilling and Remarks:

RECORD

Cased in., ft.Sand Gas Oil Total Depth

PRODUCTION

1st 24 hrs. Nat. 1st 24 hrs. after shot Gas Cu. Ft.Dry Hole Abandoned

Date

OCT 4 1944 19S. J. LEWIS Scout

Pool Name MiscellaneousMap No. 11 Sec. 21 Twp. 27 R. 6EWell No. 1 SontagH & M Drlg. CompanyCOMPLETED Contractor

SE NE SW

SECTION PLAT

990 Ft. from N. Line Ft. from S. Line330 Ft. from E. Line Ft. from W. LineButler

RECORD

Location Rig up

Drilling and Remarks:

*Viola 3012**6" C 2898**Pump 35 P.S.*Cased in., ft.Sand Gas Oil Total Depth 3014

PRODUCTION

1st 24 hrs. Nat. 1st 24 hrs. after shot Gas Cu. Ft.Dry Hole Abandoned

Date

DEC 20 1944

19

S. J. LEWIS

Scout