

Map No. 11 Sec. 22 Twp. 23 R. 13

Well No. 3 Lovett & W. Heid Farm


Jack - Barnes Company

200 Ft. from N. Line

_____ Ft. from S. Line

_____ Ft. from E. Line

1120 Ft. from W. Line

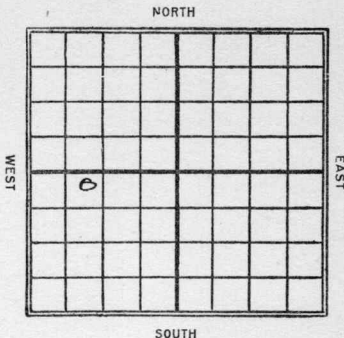

Date 7/18/22

REPORT

7/18 1100'

3/26 Topline 1713. Sand
1728-50. Shot 90 qts.
Swabbing 15 Bbls.

Map No. K17 Sec. 22 Twp. 23 R. 13

Well No. 3 - Lovett + McNeil

Jack - Barnes Company

Contractor

FIRST REPORT

SECTION PLAT

200 Ft. from N. Line
----- Ft. from S. Line
----- Ft. from E. Line
1120 Ft. from W. Line

Location -----

Rig up -----

Drilling and Remarks:

1100'

RECORD

Cased ----- in., ----- ft.

Sand -----

Gas -----

Oil -----

Total Depth -----

PRODUCTION

1st 24 hrs. Nat. -----

1st 24 hrs. after shot -----

Gas ----- Cu. Ft.

Dry Hole -----

Abandoned -----

Date

FEB 18 1922

M. A. BENEAR

191 -----

Scout

Map No. K17 Sec. 22 Twp. 23 R. 13

Well No. 3 Lovett + McNeil

Josh Barnes Company

Contractor

COMPLETED

SECTION PLAT

200' Ft. from N. Line

1120 Ft. from S. Line

1120 Ft. from E. Line

_____ Ft. from W. Line

o			

Location _____

Rig up _____

Drilling and Remarks:

Tap Line 1713

sand 1728-50

shot 90 gts

swabbing 13

RECORD

Cased _____ in., _____ ft.

Sand _____

Gas _____

Oil _____

Total Depth _____

PRODUCTION

1st 24 hrs. Nat. _____

1st 24 hrs. after shot _____

Gas _____ Cu. Ft.

Dry Hole _____

Abandoned _____

Date

MAR 26 1922

M. A. BENEAR

191 _____

Scout

~~Should this report be completed?~~

Company _____
Contractor _____

SECTION PLAT

COMPLETED

ft. from N. line
ft. from E. line
ft. from S. line
ft. from W. line

RECORD

Case No. _____

Location _____

Riv. up _____

Returned	<i>J.P.P.</i>
Cards	
Tracing	<i>Jm</i>
J. S. C. map	
Frantz map	<i>P</i>
Moody map	<i>Jm</i>
Frantz plat book	
Moody plat book	

Date _____

U. S. GEOLOGICAL SURVEY

MAR 22 1922

Sheet _____

101