
Greenwood

Form 51—5M—2-29—34703

Map No. KANSAS Sec. 22 Twp. 23 R. 13

Well No. 3 Lovett-McNeil Farm

Darby Company

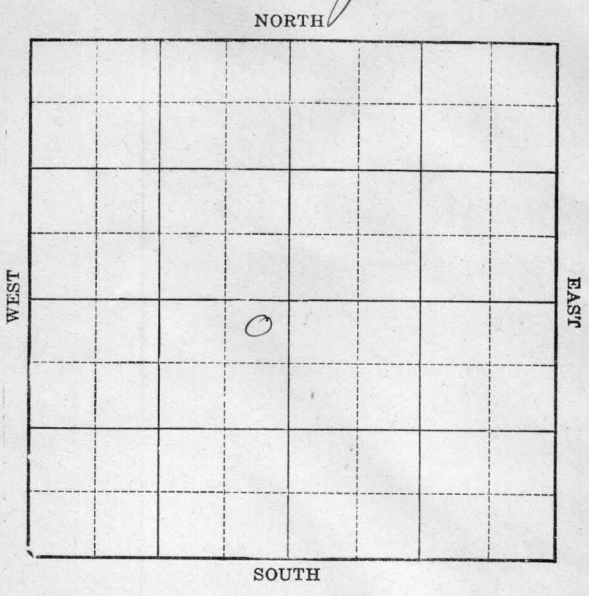

Location

Drilling Remarks

Rig Up

Drilling Remarks

RECORD

Cased in. ft.

Sand

Gas

Oil

Total Depth

PRODUCTION

1st 24 hrs. Nat.

1st 24 hrs. after shot

Gas cu. ft.

Dry Hole

Abandoned

Form 26—1M Bks.—9-26 E/Sherwood

Map No. Kns Sec. xx Twp. x3 R. 13


Well No. 3 Rosett- McNeil

Darley Company

Contractor

FIRST REPORTS COMPLETED

SECTION PLAT

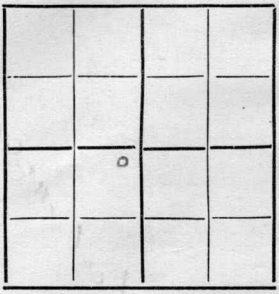

.....Ft. from N. Line

.....Ft. from S. Line

.....Ft. from E. Line

.....Ft. from W. Line

Location.....

Rig up.....

Drilling and Remarks:

80/75 BS

RECORD

Cased.....in., ...ft.

Sand 1540- 1586

Gas.....

Oil.....

Total Depth 1586

PRODUCTION

1st 24 hrs. Nat.....

1st 24 hrs. after shot.....

Gas.....Cu. Ft.

Dry Hole.....

Abandoned.....

Date

4/6/71 192..... Sherwood. Scout