


Ellis

Map No. KANSAS Sec. 27 Twp. 13 R. 16^w

Well No. 1- Reidel Farm
Twin Bly Co. Company

 Ft. from N. Line
330 Ft. from S. Line
 Ft. from E. Line
330 Ft. from W. Line

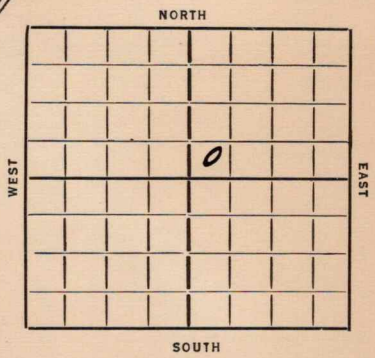

Elev. 1961

REPORT

~~1976~~
 2/12 Location
 2/20 B.P.
 2/28 Pot Rig
 3/6 Reaming hole 837
 3/13 Bly 1943 10" 696
 3/20 --
 3/27 Drlg. 2965'
 4/2 T. Oswald 3183' 7"-3183' T.D. 3184'
 WOC.
 4/10 R.U.S.T.
 4/16 Top Oswald 3212' Drlg. 3237'
 4/23 S.O. 3240-45'. T.D. 3355' S.D.
 4/30 --
 5/6/36- Sil. 3507' T.D. 3536'
 3536' water.
 D.&A.

ABANDONED

Map No. 71 Sec. 27 Twp. 13 R. 16 ~~xx~~

Well No. 1 Reidel

Twin City Company

Contractor

SECTION PLAT

..... Ft. from N. Line

330 Ft. from S. Line

..... Ft. from E. Line

330 Ft. from W. Line

		0	

ABANDONED

Location.....

Rig up.....

Drilling and Remarks:

Oil 8507
3536 Water
J & A

RECORD

Cased..... in., ft.

Sand.....

Gas.....

Oil.....

Total Depth 2536

PRODUCTION

1st 24 hrs. Nat.....

1st 24 hrs. after shot.....

Gas..... Cu. Ft.

Dry Hole.....

Abandoned.....

Date

MAY 6 1936

192

S. J. LEWIS Scout

Map No. 71 Sec. 27 Twp. 13 R. 16W

Well No. 1- Reidel

Twin Hg Co Company

Contractor

FIRST REPORTS

SECTION PLAT

Ft. from N. Line

330 Ft. from S. Line

Ft. from E. Line

330 Ft. from W. Line

		0	

Location ✓

Rig up

Drilling and Remarks:

RECORD

Cased in., ft.

Sand

Gas

Oil

Total Depth

PRODUCTION

1st 24 hrs. Nat.

1st 24 hrs. after shot

Gas Cu. Ft.

Dry Hole

Abandoned

Date

ORVAL MANNSCHRECK

2-12-36 192

Scout