

Ellis

KANSAS


SECTION 27 TOWNSHIP 13S RANGE 16W

WELL NO. #1 Reidel

COMPANY Hinkle Oil Co.

NORTH

C E/2 NE

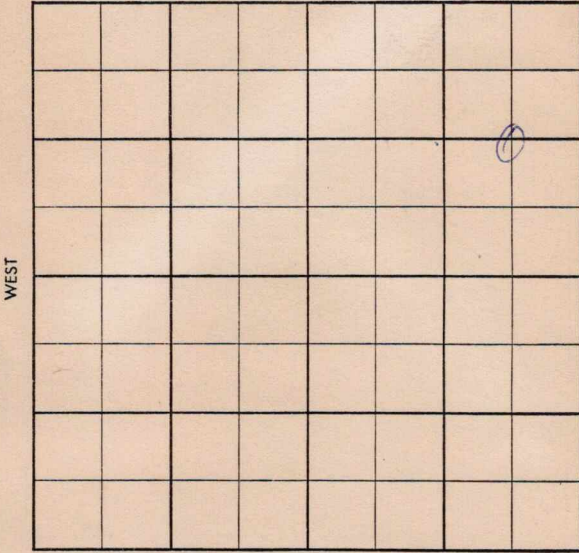

SOUTH

CO. ~~Ellis~~ ELEV. 1959
SEC. ~~27~~ TWP. 13 RGE. 16W
COMPANY ~~Hinkle Oil Co. No. 1~~

NOV 20 '57

COMPLETE

FARM Reidel

LOC. C E/2 NE/4

A 1054
H 3149
3196
Gen sd 3453
Lkc 3196

GEOL. _____
CONTR. Garvey Drlg.
an Base Disc
POOL Wildcat
SPUD 9-26
MIRT OCT 2 '57

8 5/8 193/125
M 3050 OCT 9 '57
DST 3443-55 1hr
180' GIP 1260' oil 60"
Mdy Oil BHP 1035/20"

RTD 3457 5 1/2 3453/100 DST
3188-3229 1hr 28' m FPO
BHP 0 DST 3266-89
1hr 85' m SW BHP 940/20"
DST 3443-55 60" 180' GIP
1260' oil 60' MO BHP 1035/20
5 1/2 3453/100 OCT 16 '57 CO 3457TD
\$ 32 BOPH NW 1 1/2 hrs 1000'
OB POP OCT 23 '57 OCT 30 '57
NOV 13 '57 NOV 20 POT P 59 BOPD NW

35.40 gr