


Ellis

KANSAS

SECTION 27 TOWNSHIP 13S RANGE 16W

WELL NO. #2 Reidel

COMPANY Hinkle Oil Co.

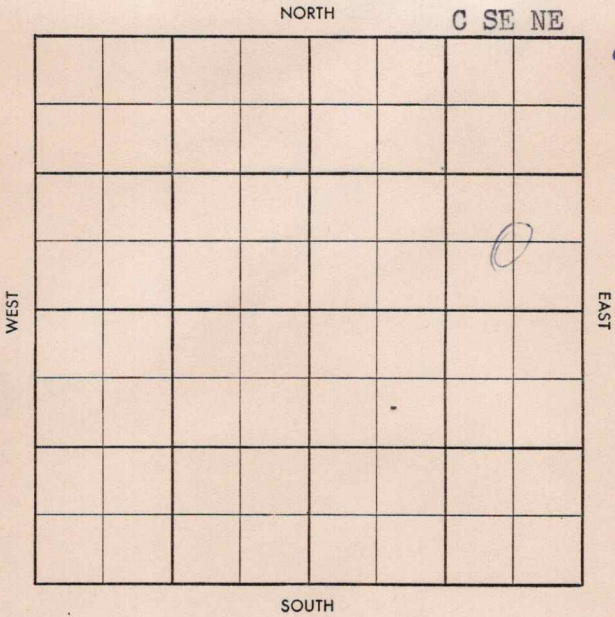

14

County Ellis Elev. 1959 DF
 Sec. 27 Twp. 13 Rge. 16W
 Company Hinkle Oil Co.
 Farm Name Reidel No. 2

TOPS	DEPTH	LOG	DATUM
Anh.	<u>1052</u>		
Tp.			
H.			
Tr.			
Dg.			
B.L.			
L.			
K.C.			
B.K.C.			
Ce.			
C.			
M.			
M.			
K.			
Mz.			
Mq.			
V.			
S.			
S.			
A.			
R.			
Pf.			
G.			
T.D.			

Loc. in Sec. _____
C SE NE
 Geol. Jirrels
 Contr. _____
B & B #1
 Pool _____
Air Base



Date Comm. 2/20/58
8" @ 209 w/150, Drlg. 2790.

Co.
Lse.
No.
Sec.
T.
R.

County Ellis Elev. 1959 DF 1962 RD
 Sec. 27 Twp. 13 Rge. 16W
 Company Hinkle Oil Co.
 Farm Name Reidel No. 2

TOPS	DEPTH	LOG	DATUM	Loc. in Sec.
Anh.	1052			<u>C SE NE</u>
Tp.				
H.	<u>3150</u>			
Tr.	<u>3171</u>			
Dg.				
B.L.				
L.	<u>3197</u>			Geol. <u>Jirrels</u>
K.C.				Contr.
B.K.C.				<u>B & B #1</u>
Ce.				Pool
C.	<u>3455</u>			<u>Air Base</u>
M.				
M.				
K.				
Mz.				
Mq.				
V.				
S.				
S.				
A.	<u>3546</u>			
R.				
Pf.				
G.				
T.D.	<u>3560</u>			

MAR 12 '58

ABANDONED

Date Comm. 2/20/58

8" @ 209 w/150, Drlg. 2790. MAR 5 '58 DST

3198-3232 60" 17' 50 CM BHP 70DST 3452 -65 60" 10' M MAR 12 '58BHP 0 DST 3452 -93 60" 180'5000 gswm BHP 341/20no logD6A