


Section 27 Township 13 S Range 16 W

Well No. #1 Riedel

Company Rudy Horman

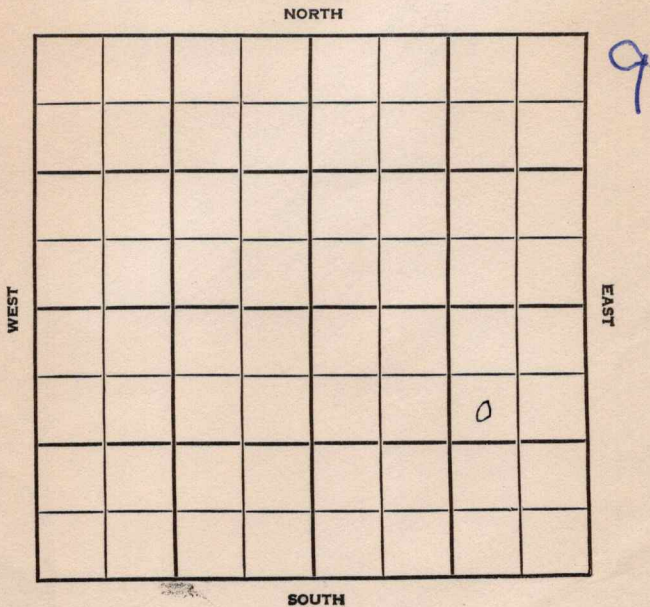

ELLIS

KANSAS

SEC.	TWP.	R.
27	13S	16W

WELL NO. #1 Riedel FARM

COMPANY Rudy Herman

CONTRACTOR Dukes


WILDCAT

_____ Ft. from N. Line

_____ Ft. from S. Line

_____ Ft. from E. Line

_____ Ft. from W. Line

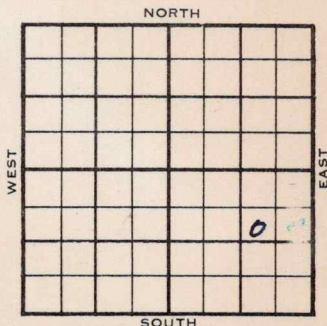

SW NE SE

1955	ELEVATION	REPORT
	1954 DF	

9/21 Comm 9-13-55
8" @ 330
D 2400

9/28 8" @ 330

Anh	1047
H	3143
L	3197
C	3445
A	3505
TD	3550
D&A	

ABANDONED

County Ellis Elev. 1954 DF
 Sec. 27 Twp. 13S Rge. 16W
 Company Rudy Herman
 Farm Name Riedel No. 1

TOPS	DEPTH	LOG	DATUM	Loc. in Sec.
Anh.				SW NE SE
Tp.				DS - SE/4
H.				
Tr.				
Dg.				
Bl.				
L.				Geol. <u>D. Vaughn</u>
K.C.				Contr.
B.K.C.				<u>Dukes</u>
Ce.				Pool
C.				<u>W.C.</u>
M.				
K.				
Mz.				
Me.				
V.				
S.				
A.				
R.				
Pe.				
G.				
T.D.				

FIRST REPORT

Date Comm. 9-13-55 SEP 21 1955
8" 330; D 2400

[Handwritten signature]

Co.
Lse.
No.
Sec.
T.
R.

County Ellis Elev. 1954
 Sec. 27 Twp. 13 Rge. 16W
 Company Rudy Herman
 Farm Name Riedel No. 1

Co.

TOPS	DEPTH	LOG	DATUM
Anh.	1047		
T.P.			
H.	3143		1189
Tr.			
Dg.			
B.L.			
L.	3197		1243
K.C.			
B.K.C.			
Ce.			
C.	3445		1491
M.			
M.			
K.			
Mz.			
Ma.			
V.			
S.			
S.			
A.	3505		1551
R.			
PE.			
G.			
T.D.	3550		

Loc. in Sec. SW NE SE

Geol. _____
 Contr. _____
Dukes

Pool Wildcat



Lse.

No.

Sec.

T.

R.

Date Comm. SEP 28 1955

8" @ 330

D & A