


Section 21 Township 27 Range 6E

Well No. 3 Tabing

Company H. M. Drlg.

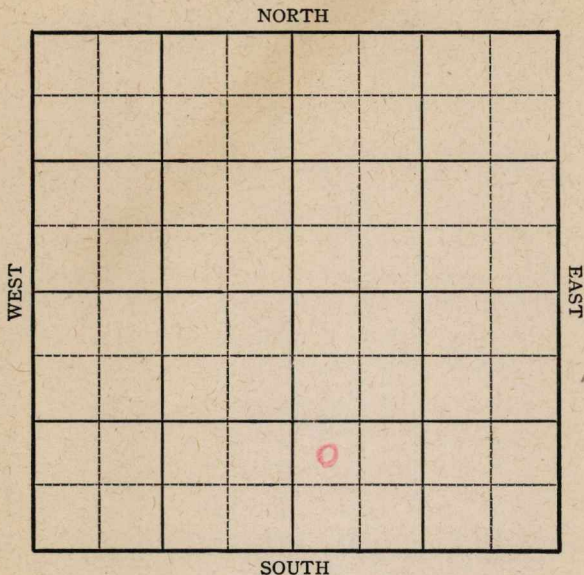

Sec. 21 Twp. 27 R. 6E

Well No. 3 Tabing Farm

H. M. Drlg. Company


Miscellaneous

           Ft. from N. Line

990 Ft. from S. Line

           Ft. from E. Line

330 Ft. from W. Line

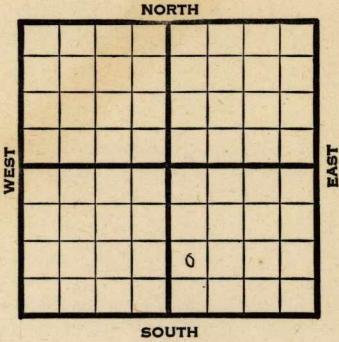

NW SW SE Elev. 1313

1945 REPORT

- 6/20 Location
- 6/28 Machine
- 7/3 15" @ 282
- Drlg. 300
- 7/11 12" @ 785'
- Drlg. 1300
- 7/19 10" @ 1640
- Lans 1710
- KC 2045
- Drlg. 2120
- 7/26 Miss. 2681-2
- 8" @ 2681
- Drlg. 2865
- 8/8 Viola 2988
- 6 @ 2983'
- T.D. 3003'
- 2000 Acid
- Pump 100 Pot
- Gravity 38.6

**COMPLETED**

Kansas Pool Name Miscellaneous

Map No. 11 Sec. 21 Twp. 27 R. 6E

Well No. 3 Tabing

H. M. Drlg. Company

**FIRST REPORT**

Contractor

NW SW SE

**SECTION PLAT**

           Ft. from N. Line

990 Ft. from S. Line

           Ft. from E. Line

330 Ft. from W. Line

		o	

Butler County

**RECORD**

Location X

Cased            in.,            ft.

Rig up           

Sand           

Drilling and Remarks:           

Gas           

Oil           

Total Depth           

**PRODUCTION**

1st 24 hrs. Nat.           

1st 24 hrs. after shot           

Gas            Cu. Ft.

Dry Hole           

Abandoned           

Date

JUN 20 1945 19

S. J. LEWIS Scout

**KANSAS** Kansas Pool Name Miscellaneous

Map No. 11 Sec. 21 Twp. 27 R. 6E

Well No. 3 Tabing

H. M. Drlg. \_\_\_\_\_ Company

**COMPLETED**

Contractor \_\_\_\_\_

NW SW SE

*E 11/313*  
**SECTION PLAT**

\_\_\_\_\_ Ft. from N. Line

990 Ft. from S. Line

\_\_\_\_\_ Ft. from E. Line

330 Ft. from W. Line

		6	

Butler County

Location \_\_\_\_\_

Rig up \_\_\_\_\_

Drilling and Remarks:

*Wota 2988*  
*6" @ 2983*  
*2000 acid*  
*Pump 100 ft*  
*38-6-4*

**RECORD**

Cased \_\_\_\_\_ in., \_\_\_\_\_ ft.

Sand \_\_\_\_\_

Gas \_\_\_\_\_

Oil \_\_\_\_\_

Total Depth 7009

**PRODUCTION**

1st 24 hrs. Nat. \_\_\_\_\_

1st 24 hrs. after shot \_\_\_\_\_

Gas \_\_\_\_\_ Cu. Ft.

Dry Hole \_\_\_\_\_

Abandoned \_\_\_\_\_

Date

AUG 8 1945 19

S. J. LEWIS Scout