


Map No. N. Sec. 22 Twp. 23 R. 13

Well No. 4 Sweet & McNeil Farm

Daily et al. Company

NORTH

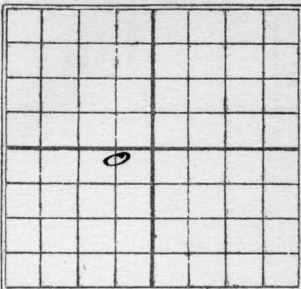

200 Ft. from N. Line

_____ Ft. from S. Line

660 Ft. from E. Line

_____ Ft. from W. Line

SOUTH

Date 1/22

REPORT

COMPLETED

1/3 elly 690'

1/15 Log 1555-1561 feet
oil - 741592
shot 8 8 1/2 lbs is
swabbing 75 lbs


Map No. 17 Sec. 22 Twp. 23 R. 13

Well No. 4 South + McNeil Farm

Harby et al. Company

Date Started _____ Ft. from N 200 S _____ E 60 W _____ line

NORTH Kansas

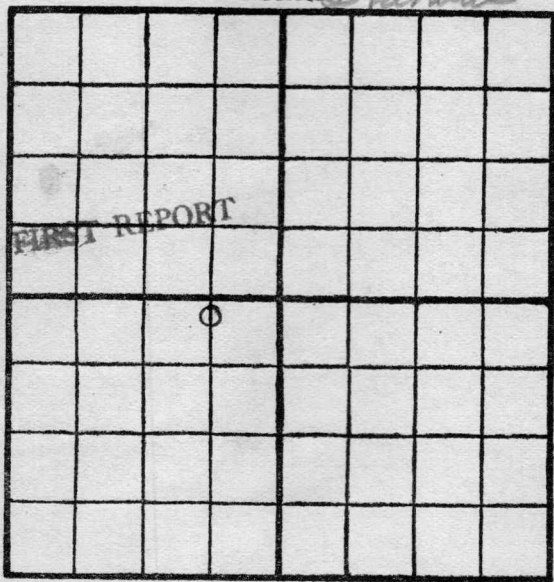

SOUTH

Cased _____ In. _____ Ft.

Sand _____

Pay { Gas _____
Oil _____

Total Depth _____

Production Remarks

Condition of Well on this date _____

Harby 690'

M. A. BENEAR

Scout

Map No. K17 Sec. 22 Twp. 23 R. 13

Well No. 4 Lovett + McNeil

Warby et al Company

Contractor

Completed

SECTION PLAT

	o		

2000' Ft. from N. Line

----- Ft. from S. Line

666' Ft. from E. Line

----- Ft. from W. Line

Location -----

Rig up -----

Drilling and Remarks:

Tap sand 1555'
First oil 1561
TD. 1392'
shot 80 qts.
and is awaiting
75 Hlb

RECORD

Cased ----- in., ----- ft.

Sand -----

Gas -----

Oil -----

Total Depth -----

PRODUCTION

1st 24 hrs. Nat. -----

1st 24 hrs. after shot -----

Gas ----- Cu. Ft.

Dry Hole -----

Abandoned -----

Date

1/15 1922 M. B. Scout