

Map No. 1 Sec. 22 Twp. 23 R. 13

Well No. 5 Lovett-McNeil Farm


Darby Company
OKO OIL Co.

250
200 Ft. from N. Line

_____ Ft. from S. Line

1070
1120 Ft. from E. Line

_____ Ft. from W. Line

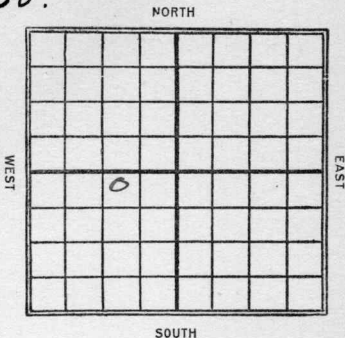

Date	REPORT
1922	O. W. D. D
2/18	1100
4/19	Sd 1629-1653 Shot 140 gts 25 bbls
1935	O. W. D. D
4/24	TML 1728 T 17 1747
5/1	450' oil 1000 acid
5/1	TML 1728 T 17 1747 1000 acid 10 Bbls.

COMPLETED

Map No. K17 Sec. 22 Twp. 23 R. 13

Well No. 5 Lovett & McNeil

Carby, Company

Contractor

FIRST REPORT

SECTION PLAT

200 Ft. from N. Line

_____ Ft. from S. Line

1120 Ft. from E. Line

_____ Ft. from W. Line

	o		

Location _____

Rig up _____

Drilling and Remarks:

1100'

RECORD

Cased _____ in., _____ ft.

Sand _____

Gas _____

Oil _____

Total Depth _____

PRODUCTION

1st 24 hrs. Nat. _____

1st 24 hrs. after shot _____

Gas _____ Cu. Ft.

Dry Hole _____

Abandoned _____

Date

FEB 18 1922

191

M. A. BENEAR

Scout

Map No. _____ Sec. 22 Twp. 23 R. 13

Well No. 5 - Lovett & McNeil
Levick oil _____ Company

_____ Contractor

COMPLETED SECTION PLAT

200 Ft. from N. Line

_____ Ft. from S. Line

1120 Ft. from E. Line

_____ Ft. from W. Line

Location _____

Rig up _____

Drilling and Remarks:

sand - 1629-1653
140 gals
25 hlb.

RECORD

Cased _____ in., _____ ft.

Sand _____

Gas _____

Oil _____

Total Depth _____

PRODUCTION

1st 24 hrs. Nat. _____

1st 24 hrs. after shot _____

Gas _____ Cu. Ft.

Dry Hole _____

Abandoned _____

Date

MAY 6 1922

M. A. BENEAR

_____ 191 _____

S

Map No. 17 Sec. 22 Twp. 23 R. 13E

Well No. 5-Lovett

Oko Oil Co (Darby formerly) Company

Contractor

FIRST REPORT

CORRECTION

SECTION PLAT

name of feet measurements

250 Ft. from N. Line

..... Ft. from S. Line

1070 Ft. from E. Line

..... Ft. from W. Line

	0		

O.W.D.

Location.....

Rig up.....

Drilling and Remarks:

OTD 1645

TML 1728

TN 1747

450' oil

1000 acid

*Do not have record
old well.*

RECORD

Cased.....in.,ft.

Sand.....

Gas.....

Oil.....

Total Depth.....

PRODUCTION

1st 24 hrs. Nat.....

1st 24 hrs. after shot.....

Gas.....Cu. Ft.

Dry Hole.....

Abandoned.....

Date

4-27-35

192.....

ORVAL MANNSCHECK
Scout

Map No. 17 Sec. 22 Twp. 23 R. 13E

Well No. 5-Louett McNeal

Ok oil Company

Contractor

COMPLETED

250 Ft. from N. Line

..... Ft. from S. Line

1070 Ft. from E. Line

..... Ft. from W. Line

SECTION PLAT

	0		

Location.....

Rig up.....

Drilling and Remarks:

1000 acid

10 lbs

RECORD

Cased..... in., ft.

Sand 7ML 1728

Gas.....

Oil.....

Total Depth 1747

PRODUCTION

1st 24 hrs. Nat.....

1st 24 hrs. after shot.....

Gas..... Cu. Ft.

Dry Hole.....

Abandoned.....

Date

5-1-35 192.....

ORVAL MANSCHRECK

Scout