


Section 21 Township 27 Range 6E

Well No. #5 Tabing

Company H & M Drlg.

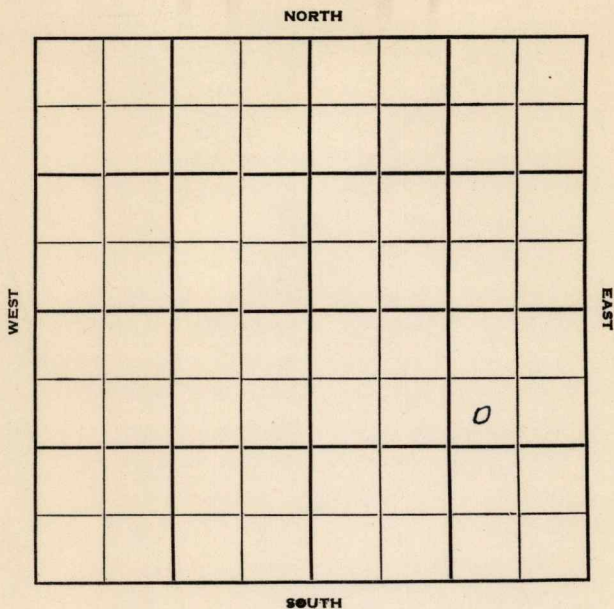

Sec. 21 Twp. 27 R. 6E

Well No. #5 Tabing Farm

H & M Drlg. Company


Contractor

990' Ft. from N. Line

_____ Ft. from S. Line

990' Ft. from E. Line

_____ Ft. from W. Line
SW NE SE

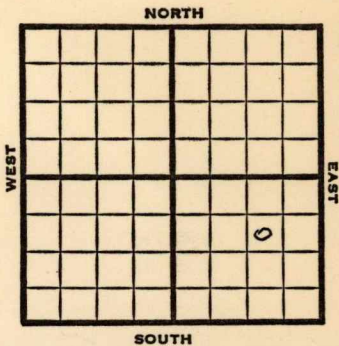

1951

Elev. 1314'

REPORT

5/2

Spud 4-28-51
8" @ 65'
Drlg. 250'

6/6

Spud 4-28-51
Oil well TD 3013'
8" @ 65' **Lans. 1710'** **KC 2040'**
Miss 2786' **Simp. 3000-13**
4" @ 2998' TD 3013' FU 300' oil
24 hr. Hydrofrac S/6-7 BOPH
Comp. 75 BOPD

COMPLETED

