


Section 29 Township 13 Range 16 W

Well No. # 1 Braun

Company Siegfried

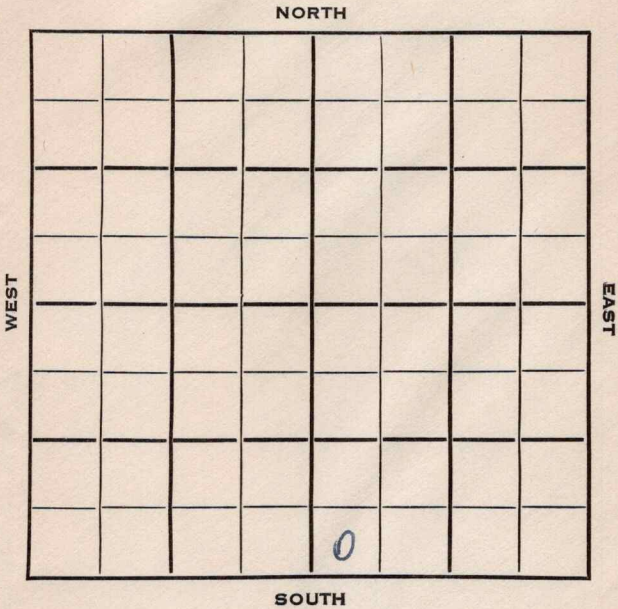

Ellis **KANSAS** ✓

Sec. 29 Twp. 13 R. 16W

Well No. #1 Braun Farm

Siegfried Company

Braden Contractor


 Ft. from N. Line

330 Ft. from S. Line

 Ft. from E. Line

330 Ft. from W. Line

SW SW SE

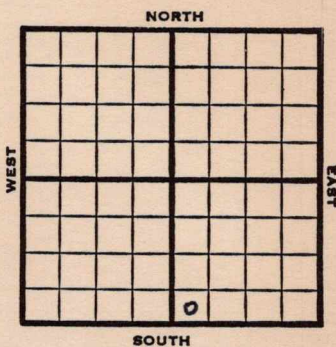

1953

Elev. 1937' REPORT

7/1

Spud 6-28-53
8" @ 190
Drlg. 375'

7/8

Anhy 1060, Heeb 3156, Lans 3200
DST 3220-46, 1 hr, 30' OCM, 140#
DST 3293-3304, 1/2 hr, 100' M,
Drlg 3304'

7/15

Spud 6-28-53
D & A TD 3510 8" @ 190
Anhy 1060 Heeb 3156 Lans 3200
DST 3220-46 open 1 hr rec 30' OCM
140#
DST 3293-3304 open 1/2 hr rec 100' mud
Cong 3449 Arb. 3479 TD 3510'
D & A

ABANDONED

County Ellis State Kansas

Sec. 29 (Blk.) 13 (Sur. Rge.) 16W Map No.

Operator Siegfried

Well No. 1 Farm Braun

Elev. _____ Location SW SW SE

330 Ft. From S Line SE

330 Ft. From W Line Quarter

1st. Report JUL 1 1953

Completion _____

Remarks _____

Braden - Contr.

Spudding Date 6-28-53

FIRST REPORT

Drlg. Data _____

8" @ 190 drlg. 375

