

KANSAS

Ellis county

Section 29 Township 13 Range 16-W

Well No. #1, Mermis

Company ~~Reed Gartsen~~

John Lindas

NORTH

WEST

EAST

SOUTH

KANSAS

Ellis County

Sec. 29 Twp. 13 R. 16W

Well No. #1 Mermis Farm

~~Reed Cartsen~~ John Lindas Company

Herzog


330 Ft. from N. Line

_____ Ft. from S. Line

_____ Ft. from E. Line

330 Ft. from W. Line

NW/c

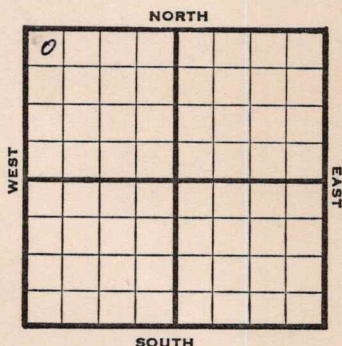

1946

1968

REPORT

8/28 Anhy. 1101

8" @ 1113

Drlg. 3387'

9/5 Lans 3240'

Arb 3483

TD 3486 SO

5" @ 3485 RUST

9/10 " "

9/18 TD3491'

500 acid swb 7 oil PH 15 hrs

9/24 " " "

10/1 " " "

10/8 " " "

10/15 " " "

10/22 " " "

10/29 " " "

11/6 " " "

11/13 Arb 3483'

5" @ 3485'

500 Acid

Pump 154 POT

TD 3491'


27 Grav.

COMPLETED

KANSASKansas Pool Name HerzogMap No. 71 Sec. 29 Twp. 13 R. 16WWell No. 1 MermisReed Cartsen Company**FIRST REPORT**

Contractor

NW/C

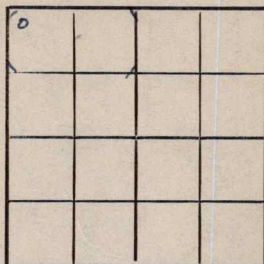SECTION PLAT330 Ft. from N. Line Ft. from S. Line Ft. from E. Line330 Ft. from W. LineEllis CountyLocation Rig up

Drilling and Remarks:

Anhy. 1101'8" @ 1113'3387'**RECORD**Cased in., ft.Sand Gas Oil Total Depth **PRODUCTION**1st 24 hrs. Nat. 1st 24 hrs. after shot Gas Cu. Ft.Dry Hole Abandoned

Date

AUG 28 1946 19S. J. LEWIS Scout

KANSAS Kansas Pool Name Herzog

Map No. 77 Sec. 29 Twp. 13 R. 16W

Well No. 1 Mermis

John Lindas Company

CORRECTION Contractor

NW/C

SECTION PLAT

330 Ft. from N. Line

 Ft. from S. Line

 Ft. from E. Line

330 Ft. from W. Line

0			

Ellis County

Location

Rig up

Drilling and Remarks:

Reported as

Reed - Cartsen

RECORD

Cased in., ft.

Sand

Gas

Oil

Total Depth

PRODUCTION

1st 24 hrs. Nat.

1st 24 hrs. after shot

Gas Cu. Ft.

Dry Hole

Abandoned

Date

SEP 5 1946 19

S. J. LEWIS

Scout

Map No. 71 Sec. 29 Twp. 13 R. 16W

Well No. 1 Mermis

John Lindas

Company

COMPLETED

Contractor

NW/C

E. 11968
SECTION PLAT

0			

330 Ft. from N. Line

 Ft. from S. Line

 Ft. from E. Line

330 Ft. from W. Line

Ellis County

Location

Rig up

Drilling and Remarks:

Per 3483
5103485
500 Acid
Pump 154 Bd
270 Gr

RECORD

Cased in., ft.

Sand

Gas

Oil

Total Depth 3491

PRODUCTION

1st 24 hrs. Nat.

1st 24 hrs. after shot

Gas Cu. Ft.

Dry Hole

Abandoned

Date

NOV 13 1946

19

S. J. LEWIS

Scout