


Section 22 Township 23 Range 13-E

Well No. 12 Lovett-McNeil

Company OKO Oil

NORTH Virgil Pool

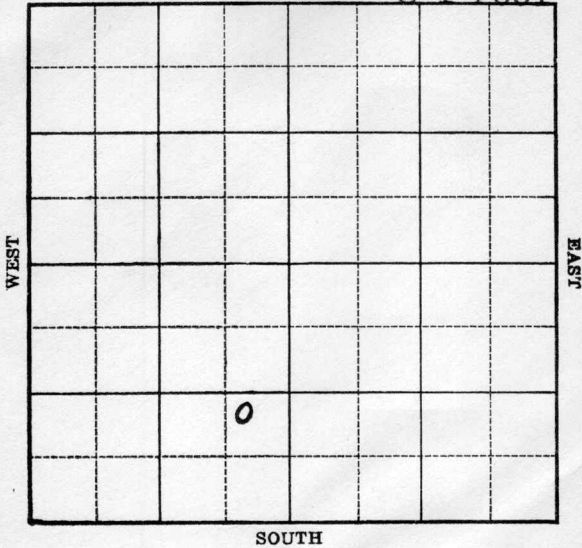



Map No. 17 Sec. 22 Twp. 23 R. 13EWell No. 12 Lovett-McNeilOKO Oil

Company

Contractor

## FIRST REPORT

NE SE SW

         Ft. from N. Line1000 Ft. from S. Line450 Ft. from E. Line         Ft. from W. Line

VIRGIL POOL

## SECTION PLAT

	o		

Location                                 Rig up                                 

Drilling and Remarks:

Spud

## RECORD

Cased          in.,          ft.Sand                                 Gas                                 Oil                                 Total Depth                         

## PRODUCTION

1st 24 hrs. Nat.                         1st 24 hrs. after shot                         Gas                                  Cu. Ft.Dry Hole                                 Abandoned                                 

Date

MAR 22 1939

19

H. D. Hatfield Scout

Map No. 17 Sec. 22 Twp. 23 R. 13E

Well No. 12 Lovett-McNeil

OKO

Company

Contractor

**COMPLETED**

**SECTION PLAT**

NE SE SW

	0		

         Ft. from N. Line

1000 Ft. from S. Line

450 Ft. from E. Line

         Ft. from W. Line

**VIRGIL POOL**

Location                                 

Rig up                                 

Drilling and Remarks:

*Pot. - 25 oil +  
100 wtr*

**RECORD**

Cased 8 in., 1425 ft.

Sand Bart 1550

Gas                                 

Oil                                 

Total Depth 1590

**PRODUCTION**

1st 24 hrs. Nat.                                 

1st 24 hrs. after shot                                 

Gas                                  Cu. Ft.

Dry Hole                                 

Abandoned                                 

Date

APR 19 1939

H. D. Hatfield Scout