

KANSAS

Ellis ✓

Sec. 30 Twp. 13 R. 16W

Well No. 2 Dorr (Gore, Theodore) Farm
Gulf Company

Dorr

Ft. from N. Line

990


Ft. from S. Line

990

Ft. from E. Line

Ft. from W. Line

NW SE NE

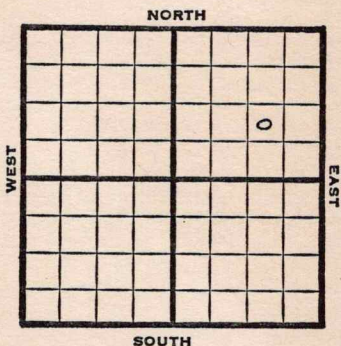

1947

Elev. 1967'

REPORT

4/30

RUR
Drlg 1925'

5/13

Drlg. 3162'

5/20

Lans 3218
Arb 3466-68
TD 3468'
5" @ 3467'
RUST

5/27

TD 3475'
1000 Acid.

6/3

" "

6/10

" "

6/17

" "

6/25

TD 3475'
Arbuckle 3466'
5" @ 3467'
1000 Acid
Echo Pot 840
Gr. 29 °.
Complete

COMPLETED

Map No. K 71 Sec. 30 Twp. 13 R. 16W

Well No. 2 Dorr

Gulf Company

FIRST REPORT Contractor

NW SE NE

SECTION PLAT

_____ Ft. from N. Line

990 Ft. from S. Line

990 Ft. from E. Line

_____ Ft. from W. Line

			o

Ellis County

Location _____

Rig up _____

Drilling and Remarks:

R U R

RECORD

Cased _____ in., _____ ft.

Sand _____

Gas _____

Oil _____

Total Depth _____

PRODUCTION

1st 24 hrs. Nat. _____

1st 24 hrs. after shot _____

Gas _____ Cu. Ft.

Dry Hole _____

Abandoned _____

Date

APR 30 1947 19

S. J. LEWIS Scout

Kansas

Map No. 71 Sec. 30 Twp. 13 R. 16W

Well No. 2 Dorr

Gulf

Company

COMPLETE

Contractor

NW SE NE

E. J. Lewis

SECTION PLAT

			0

_____ Ft. from N. Line

990 Ft. from S. Line

990 Ft. from E. Line

_____ Ft. from W. Line

Ellis County

Location _____

Rig up _____

Drilling and Remarks:

Cor # 3466
5" @ 3467
1000 acid
Ech to 3484
29° SW

RECORD

Cased _____ in., _____ ft.

Sand _____

Gas _____

Oil _____

Total Depth 2425

PRODUCTION

1st 24 hrs. Nat. _____

1st 24 hrs. after shot _____

Gas _____ Cu. Ft.

Dry Hole _____

Abandoned _____

Date

JUN 25 1947 19

S. J. LEWIS Scout