


Ellis  
KANSAS

O.W.W.O.

Section 30 Township 13 Range 16W

Well No. 2 Kuhn #1 Honey Braun

Company G. G. Kissenger Carl Todd Hely

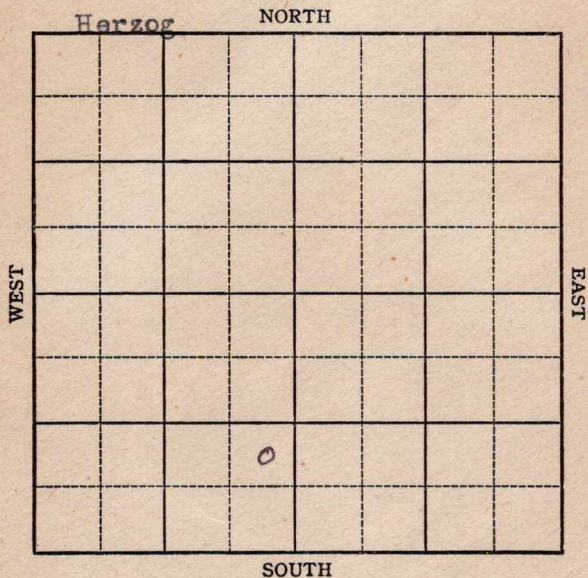

KANSAS Ellis **O.W.W.O.** ✓

Sec. 30 Twp. 13 R. 16W

Well No. #2 Kuhn #1 Honey Braun Farm

C. G. Kissenger Carl Todd Drlg Company

Herzog


           Ft. from N. Line

990 Ft. from S. Line

330 Ft. from E. Line

           Ft. from W. Line

NE SE SW

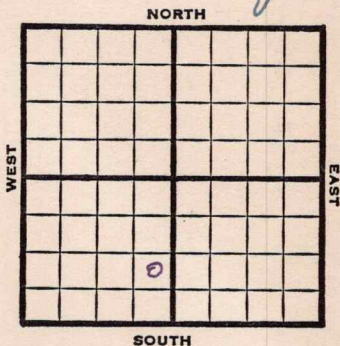

1947 **Elev.** REPORT **1970'**

7/23 Location

7/29 8" @ 230'  
Drlg. 2100'

8/6 **Lansing 3222'**  
Drlg 3348'

8/13 TD 3525'

8/20 "

8/27 **Arbuckle 3520'**  
Total Depth 8560'

**ABANDONED**

1956

**O.W.W.O.**

4-11 CO to 3526  
DST 3258-82 op 1 hr. rec. 90' muddy wtr  
845/15"  
DST 3411-3526 op 1 hr. rec. 50' muddy  
wtr., 960/15"  
D & A

**H. 3195, L. 3222, A. 3520,**  
TD 3550'

**ABANDONED**

**Kansas**

Map No. \_\_\_\_\_ Sec. 30 Twp. 13 R. 16W

Well No. 2 Kuhn

C. G. Kissenger Company

FIRST REPORT Contractor

NE SE SW

**SECTION PLAT**

\_\_\_\_\_ Ft. from N. Line

990 Ft. from S. Line

330 Ft. from E. Line

\_\_\_\_\_ Ft. from W. Line


Ellis County

Location X

Rig up \_\_\_\_\_

Drilling and Remarks:

**RECORD**

Cased \_\_\_\_\_ in., \_\_\_\_\_ ft.

Sand \_\_\_\_\_

Gas \_\_\_\_\_

Oil \_\_\_\_\_

Total Depth 183

**PRODUCTION**

1st 24 hrs. Nat. \_\_\_\_\_

1st 24 hrs. after shot \_\_\_\_\_

Gas \_\_\_\_\_ Cu. Ft.

Dry Hole \_\_\_\_\_

Abandoned \_\_\_\_\_

Date

**JUL 23 1947**

19

**S. J. LEWIS**

Scout

Map No. 71 Sec. 30 Twp. 13 R. 16W

Well No. 2 Kuhn

C. G. Kissenger Company

**ABANDONED** Contractor

NE SE SW

*E11970*  
SECTION PLAT

\_\_\_\_\_ Ft. from N. Line

990 Ft. from S. Line

330 Ft. from E. Line

\_\_\_\_\_ Ft. from W. Line


Ellis County

Location \_\_\_\_\_

Rig up \_\_\_\_\_

Drilling and Remarks:

*Cu 8520*

**RECORD**

Cased \_\_\_\_\_ in., \_\_\_\_\_ ft.

Sand \_\_\_\_\_

Gas \_\_\_\_\_

Oil \_\_\_\_\_

Total Depth 8560

**PRODUCTION**

1st 24 hrs. Nat. \_\_\_\_\_

1st 24 hrs. after shot \_\_\_\_\_

Gas \_\_\_\_\_ Cu. Ft.

Dry Hole \_\_\_\_\_

Abandoned \_\_\_\_\_

Date

AUG 27 1947

19

S. J. LEWIS

Scout

284045  
044045

O.W.W.O.

FORM 513 SUNRAY

O.W.O.

County Ellis Elev. 1971  
 Sec. 30 Twp. 13 Rge. 16W  
 Company Carl Todd Drlg.  
 Farm Name Honey Braun No. 1

TOPS	DEPTH	LOG	DATUM	Loc. in Sec.
Anh.				NE SE SW
TP.				
H.	3195			
Tr.				
Dg.				
Bl.	3222			Geol. _____
L.				Contr. _____
K.C.				
B.K.C.				
Ce.				
C.				
M.				Pool _____
M.				
K.				
Mz.				
Me.				
V.				
S.				
S.	3520			
A.				
R.				
Pe.				
G.				
T.D.	3550			

FIRST REPORT  
 APR 11 '58  
 ABANDONED

Date Comm. (was Kissinger #2 Kuhn  
 GO to 3526 DST 3258-82 open 1 hr.  
 rec. 90' muddy wtr. 845/15"  
 DST 3411-3526 open 1 hr. rec. 50'  
 muddy wtr. 960/15"  
 D & A  
 R.G.

Co.  
Lse.  
No.  
Sec.  
T.  
R.