

Greenwood


KANSAS

FORM 51 5M 2-38 TPCO.

Section 16 Township 23 Range 13-E

Well No. #4 Shindler

Company O. F. Duncan

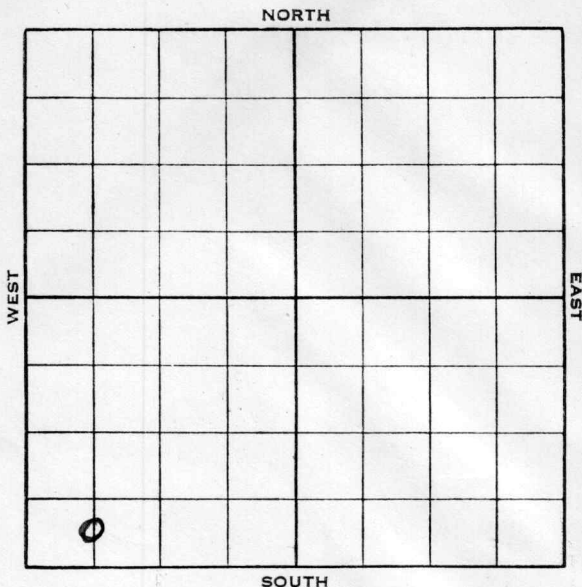

Sec. 16 Twp. 23 R. 13-E

Well No. #4 Shindler Farm


O. F. Duncan Company

_____ Ft. from N. Line

330 Ft. from S. Line

_____ Ft. from E. Line

660 Ft. from W. Line

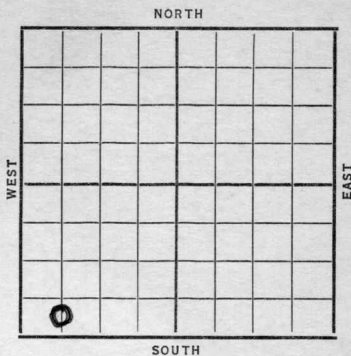

Date	REPORT
1937	
7/14	Drlg. 670'.
7/23	Drlg. 840'.
7/30	" "
8/6	T.D. 840' fsg.
8/13	12" @ 450'. Drlg. 855'.
8/20	8" @ 1343'. Drlg. 1525'.
8/28	Miss. 1732'. 6" @ 1735'.
	Pay 1743-50'. T.D. 1751'.
	Est. 15 bbls. oil per day Nat.
	2000 acid.
9/3	" "
9/8	6" @ 1735'.
	Miss. L. 1732'.
	T.D. 1751'.
	2000 acid.
	50 bbls.
	COMPLETED

Map No. 17^M Sec. 16 Twp. 23 R. 13^E

Well No. 4 - Shindler

O. S. Duncan Company

Contractor

FIRST REPORT

SECTION PLAT

_____ Ft. from N. Line

330 Ft. from S. Line

_____ Ft. from E. Line

660 Ft. from W. Line

Location _____

Rig up _____

Drilling and Remarks:

D/g 670

RECORD

Cased _____ in., _____ ft.

Sand _____

Gas _____

Oil _____

Total Depth _____

PRODUCTION

1st 24 hrs. Nat. _____

1st 24 hrs. after shot _____

Gas _____ Cu. Ft.

Dry Hole _____

Abandoned _____

Date

JUL 14 1937

19

H. D. Hatfield Scout

Map No. 17^N Sec. 16 Twp. 23 R. 13E

Well No. 4 - Shindler

O. F. Duncan

Company

Contractor

COMPLETED

SECTION PLAT

0			

 Ft. from N. Line

330 Ft. from S. Line

 Ft. from E. Line

660 Ft. from W. Line

Location

Rig up

Drilling and Remarks:

2000 acid

50 bbls

RECORD

Cased 6 in., 1735 ft.

Sand Miss. L. 1732

Gas

Oil

Total Depth 1751

PRODUCTION

1st 24 hrs. Nat.

1st 24 hrs. after shot

Gas Cu. Ft.

Dry Hole

Abandoned

Date

SEP 8 1937

H. D. Hatfield

19

Scout

Greenwood

Map No. _____ Sec. 16 Twp. 23 R. 13 E

Well No. 4 Shindler

O. F. Duncan Company

Contractor

COMPLETED
DUPLICATE
COMP. 8-37

SECTION PLAT

0			

_____ Ft. from N. Line

330 Ft. from S. Line

_____ Ft. from E. Line

660 Ft. from W. Line

Location _____

Rig up _____

Drilling and Remarks:

Good and

EST 50 bbls oil
Per day

12" - 450
8" - 1343
RECORD

Cased 6 in.; 1735 ft.

Sand MISS 1732

Gas _____

Oil _____

Total Depth 1751

PRODUCTION

1st 24 hrs. Nat. _____

1st 24 hrs. after shot _____

Gas _____ Cu. Ft.

Dry Hole _____

Abandoned _____

Date

8-20 1938 R. D. Hatfield Scout