

KANSAS

Ellis

Form 51—5M—7-39—Palace

Section 30 Township 13 Range 16-W

Well No. #1 Peter J. Sanders

Company Gulf & Gled Oil


Wildcat

NORTH

WEST

EAST

SOUTH

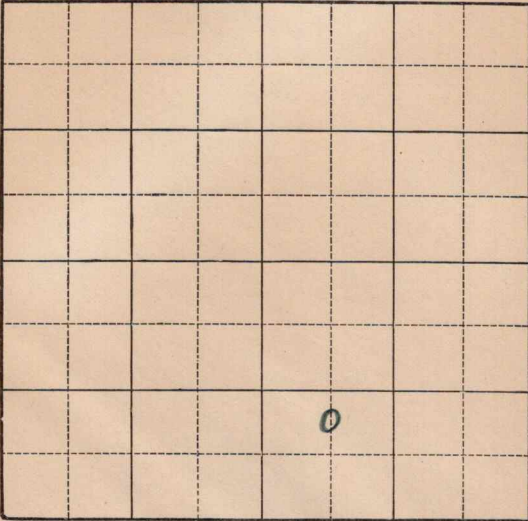

KANSAS

Ellis

Sec. 30 Twp. 13 R. 16-WWell No. #1 Peter J. Sanders FarmGulf & Gled Oil Company

(Wildcat)

Ft. from N. Line

990


Ft. from S. Line

Ft. from E. Line

660

Ft. from W. Line

Elev. 1944

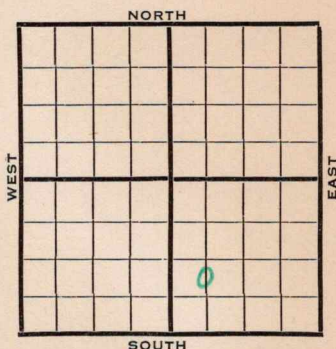

REPORT

1940	
5/1	13" - 215' WOC 245'
5/9	1063' Anhy. Fsg. 2338'
5/16	XXXX Tarkio 2705'
	Topeka 2940' Drlg. 3123'
5/23	K.C. 3203' Show heavy oil 3299½'
	Drlg. 3309'
5/29	Arb. 3450 -56' T.D. Sat.
	5½" - 3450' RUST.
6/6	T.D. 3458' Swab 3 bbls. per hour 3 hours.
6/13	2000 acid. Pump 204 bbls. oil 120 bbls. water 21 hours.
6/19	Arb. 3450'
	5" - 3450'
	T.D. 3458'
	2000 acid.
	Pump 312 oil & 144 water.

COMPLETED

Map No. 77 Sec. 30 Twp. 13 R. 16WWell No. 1 Peter J. SandersGulf & Gled Oil

Company

Contractor

FIRST REPORT

C $N\frac{1}{2}$ SW SE


Ft. from N. Line

990 Ft. from S. Line

Ft. from E. Line

660 Ft. from W. Line

SECTION PLAT

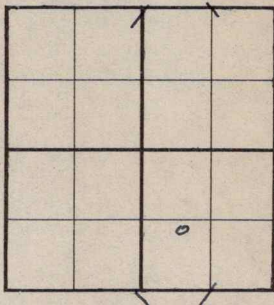

WILDCAT

Location _____

Rig up _____

Drilling and Remarks:

13" - 215WOC 245

RECORD

Cased _____ in., _____ ft.

Sand _____

Gas _____

Oil _____

Total Depth _____

PRODUCTION

1st 24 hrs. Nat. _____

1st 24 hrs. after shot _____

Gas _____ Cu. Ft.

Dry Hole _____

Abandoned _____

Date

MAY 1 1940 19S. J. LEWIS Scout


Map No. 71 Sec. 30 Twp. 13 R. 16WWell No. 1 Peter J. SandersGulf & Gled Oil

Company

Contractor

COMPLETED

SECTION PLAT

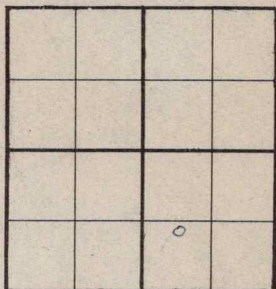C $N\frac{1}{2}$ SW SE Ft. from N. Line990 Ft. from S. Line Ft. from E. Line660 Ft. from W. Line

WILDCAT

Location Rig up

Drilling and Remarks:

*Cur & 3450**5" @ 3450**2000 acid**Pump 312 oil**144 Water*

RECORD

Cased in., ft.Sand Gas Oil Total Depth 3458

PRODUCTION

1st 24 hrs. Nat. 1st 24 hrs. after shot Gas Cu. Ft.Dry Hole Abandoned

Date

JUN 19 1940 19S. J. LEWIS Scout