


KANSAS Ellis County

FORM 51 5M PETROL

Section 2 30 Township 13 Range 16W

Well No. 3 Sanders

Company Gled Oil and Gulf

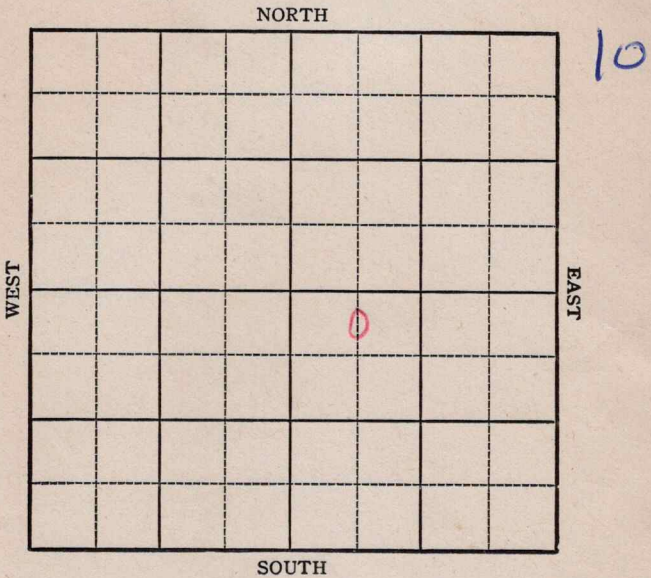

KANSAS

Ellis

Sec. 30 Twp. 13 R. 16W


Well No. 3 Sanders Farm _____
Gled Oil and Gulf Company

Herzog
330 Ft. from N. Line

_____ Ft. from S. Line

_____ Ft. from E. Line

660 Ft. from W. Line

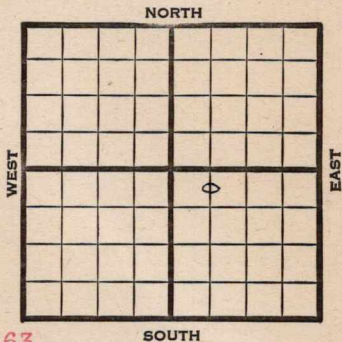

C N L NW SE Elev. 1963

1945

REPORT

5/16 anhy 1112
8" -1125'
1450'

5/24 Drlg. 3196'
5/31 5" @ 3498'
TD 3498' RUST

6/8 Lans 3241 BKO 3462 Arb. 3478
TD 3481 corrected 5" @ 3478
500 acid 2000' oil in 4 hrs.

~~6/14~~ " " " " "

6/21 " " " " "

6/28 " " " " "

7/3 " " " " "

7/11 " " " " "

7/18 **Arb. 3478**
5" @ 3478
TD 3481'
500 acid.
Pump 95 Pot.
Grav. 37.5

COMPLETED

Pool Name Herzog

Kansas

Map No. 71 Sec. 2 Twp. 13 R. 16W

Well No. 3 Sanders

Gled Oil and Gulf Company

FIRST REPORT

Contractor

C N L NW SE

SECTION PLAT

330 Ft. from N. Line

_____ Ft. from S. Line

_____ Ft. from E. Line

660 Ft. from W. Line

		o	

Ellis

Location _____

Rig up _____

Drilling and Remarks:

anhy 1112
8"-1125
1450

RECORD

Cased _____ in., _____ ft.

Sand _____

Gas _____

Oil _____

Total Depth _____

PRODUCTION

1st 24 hrs. Nat. _____

1st 24 hrs. after shot _____

Gas _____ Cu. Ft.

Dry Hole _____

Abandoned _____

Date

MAY 16 1945

19

S. J. LEWIS Scout

Kansas Pool Name Herzog

Map No. 71 Sec. 30 Twp. 13 R. 16W

Well No. 3 Sanders

Gled Oil and Gulf Company

CORRECTION

Contractor

C N L NW SE

SECTION PLAT

330 Ft. from N. Line

_____ Ft. from S. Line

_____ Ft. from E. Line

660 Ft. from W. Line

		o	

Ellis

Location _____

Rig up _____

Drilling and Remarks:

reported in
2-13-16W

RECORD

Cased _____ in., _____ ft.

Sand _____

Gas _____

Oil _____

Total Depth _____

PRODUCTION

1st 24 hrs. Nat. _____

1st 24 hrs. after shot _____

Gas _____ Cu. Ft.

Dry Hole _____

Abandoned _____

Date

MAY 23 1945

19

S. J. LEWIS

Scout

