

Ellis


KANSAS

FORM 51 IOM 12-46 PETROL

Section 30 Township 13 Range 16W

Well No. 4 Sanders

Company Gledde Oil & Gulf.

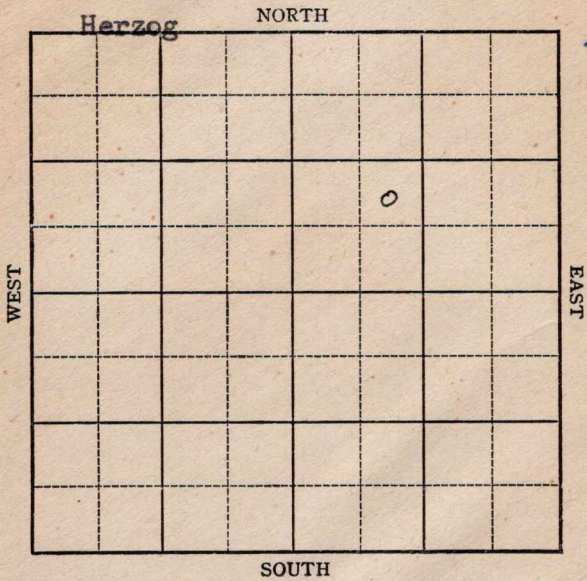

KANSAS

Sec. 30 Twp. 13 R. 16W

Well No. 4 Sanders Farm

Gleade Oil & Gulf

Company

Herzog

Ft. from N. Line


990

Ft. from S. Line

Ft. from E. Line

990

Ft. from W. Line

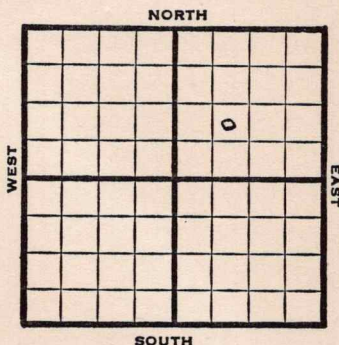

NE SW NE

1947 Elev. 1967' REPORT

4/30

Anhy 1108
8" @ 1110
Dr1g. 2000'.

5/7

" "

5/13

Lansing 3232'
Arbuckle 3471'
TD 3472'
5" @ 3472'
RUST

5/20

TD 3480'
Swb 5 bbls oil PH 5 hrs

5/27

" "

6/3

" "

6/10

" "

6/17

" "

6/24

" "

OVER

740464

7/2

Arb. 3471'

5" @ 3472'

Pump 159 oil / 33% w. Pot

27.0 Gr.

TD 3480'

COMPLETED

Map No. K 71 Sec. 30 Twp. 13 R. 16W

Well No. 4 Sanders

Gledde Oil & Gulf Company

FIRST REPORT Contractor

NE SW NE

SECTION PLAT

 Ft. from N. Line

990 Ft. from S. Line

 Ft. from E. Line

990 Ft. from W. Line

		0	

Ellis County

Location

Rig up

Drilling and Remarks:

Anhy 1108

8" @ 1110

dr1g. 2000

RECORD

Cased in., ft.

Sand

Gas

Oil

Total Depth

PRODUCTION

1st 24 hrs. Nat.

1st 24 hrs. after shot

Gas Cu. Ft.

Dry Hole

Abandoned

Date

APR 30 1947

19

S. J. LEWIS

Scout

Map No. 71 Sec. 30 Twp. 13 R. 16W

Well No. 4 Sanders

Gledde Oil & Gulf Company

COMPLETE

Contractor

NE SW NE


E 11967
SECTION PLAT

 Ft. from N. Line

990 Ft. from S. Line

 Ft. from E. Line

990 Ft. from W. Line

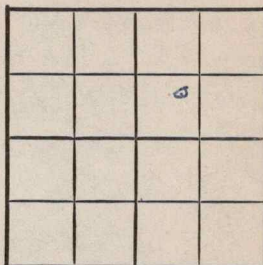

Ellis County

Location

Rig up

Drilling and Remarks:

Ac 8471

5' 03472

Pump. 159 oil +

37% W Pot

27 2/3

RECORD

Cased in., ft.

Sand

Gas

Oil

Total Depth 3480

PRODUCTION

1st 24 hrs. Nat.

1st 24 hrs. after shot

Gas Cu. Ft.

Dry Hole

Abandoned

Date

JUL 2 1947 19

S. J. LEWIS Scout