

KANSAS


FORM 51 5M PETROL

Greenwood

Section 16 Township 23 Range 13-E

Well No. #5 Schindler

Company O. F. Duncan

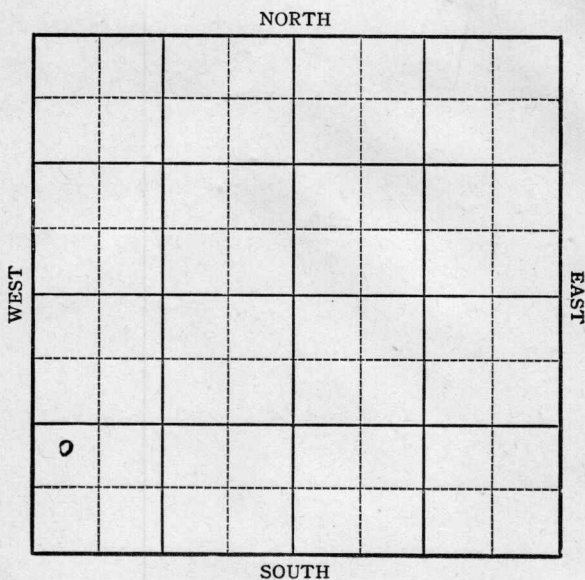


Sec. 16 Twp. 23 R. 13-E

Well No. #5 Schindler Farm

O. F. Duncan Company

NORTH

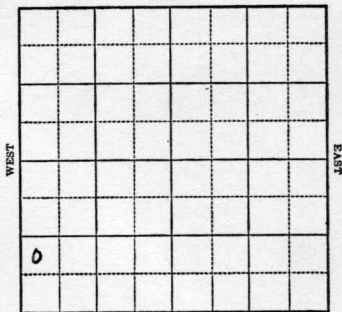

 Ft. from N. Line

990 Ft. from S. Line

 Ft. from E. Line

330 Ft. from W. Line

SOUTH

1943

R E P O R T

10/20

Machine

10/27

Drlg. 440'

11/3

12" @ 475

Drlg. 915'

11/10

8" @ 1397

Drlg. 1475'

11/17

Miss 1754

TD 1782

7" @ 1754

WOC

12-1

7" @ 1754

Miss 1754

TD 1782

500 Acid

Pump 25 Pot.

Graivty 36.0

COMPLETED

KANSAS

Map No. 17 Sec. 16 Twp. 23 R. 13EWell No. 5 SchindlerO. F. Duncan


Company

FIRST REPORT

Contractor

NW SW SW

SECTION PLAT

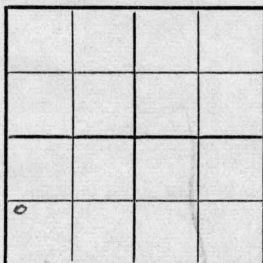 Ft. from N. Line990 Ft. from S. Line Ft. from E. Line330 Ft. from W. Line

Miscellaneous

Location Rig up

Drilling and Remarks:

Machine

RECORD

Cased in., ft.Sand Gas Oil Total Depth

PRODUCTION

1st 24 hrs. Nat. 1st 24 hrs. after shot Gas Cu. Ft.Dry Hole Abandoned

Date

OCT 20 1943 19S. J. LEWIS Scout

KANSAS

Map No. 17 Sec. 16 Twp. 23 R. 13EWell No. 5 SchindlerO. F. Duncan

Company

COMPLETED

Contractor

NW SW SW

SECTION PLAT

0			

Ft. from N. Line

990 Ft. from S. Line

Ft. from E. Line

330 Ft. from W. Line

Miscellaneous

Location

Rig up

Drilling and Remarks:

*Miss 1754**7" @ 1754**500 Acid**Pump 2500 ft**360 ft*

RECORD

Cased _____ in., _____ ft.

Sand _____

Gas _____

Oil _____

Total Depth 1782

PRODUCTION

1st 24 hrs. Nat. _____

1st 24 hrs. after shot _____

Gas _____ Cu. Ft.

Dry Hole _____

Abandoned _____

Date

DEC 1 1943

19

S. J. LEWIS Scout