


Section 16 Township 23 Range 13-E

Well No. 5 - Shindler

Company O. F. Duncan

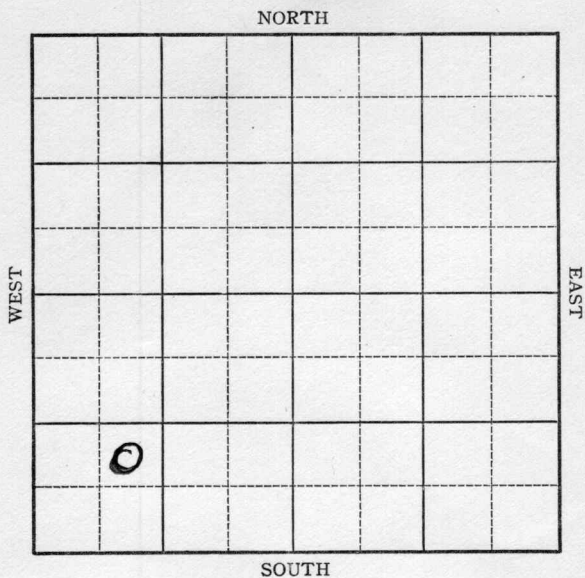

KANSAS Greenwood

Map No. 17^M Sec. 16 Twp. 23 R. 13E

Well No. 5-Shindler

O. F. Duncan Company

Ma Contractor

FIRST REPORT

SECTION PLAT

_____ Ft. from N. Line

837 Ft. from S. Line

_____ Ft. from E. Line

975 Ft. from W. Line

o			

Location _____

Rig up _____

Drilling and Remarks:

Ma

RECORD

Cased _____ in., _____ ft.

Sand _____

Gas _____

Oil _____

Total Depth _____

PRODUCTION

1st 24 hrs. Nat. _____

1st 24 hrs. after shot _____

Gas _____ Cu. Ft.

Dry Hole _____

Abandoned _____

Date

SEP 1 1937 19

H. D. Hatfield Scout

Greenwood KANSAS

Map No. 17M Sec. 16 Twp. 23 R. 13E

Well No. 5 Shindler

O F Duncan Company

Contractor

ABANDONED
NE SW SW

SECTION PLAT

_____ Ft. from N. Line

837 Ft. from S. Line

_____ Ft. from E. Line

975 Ft. from W. Line

0			

Location _____

Rig up _____

Drilling and Remarks:

H. F. W.
DYA

RECORD

Cased 6 in., 1740 ft.

Sand MISS 1740

Gas _____

Oil _____

Total Depth 1790

PRODUCTION

1st 24 hrs. Nat. _____

1st 24 hrs. after shot _____

Gas _____ Cu. Ft.

Dry Hole _____

Abandoned _____

Date

OCT - 6 1937 19

H. D. Hatfield Scout