


Map No. Kane Sec. 22 Twp. 27 R. 6^E
 Well No. #1 Gessler Farm
Wentz et al Company

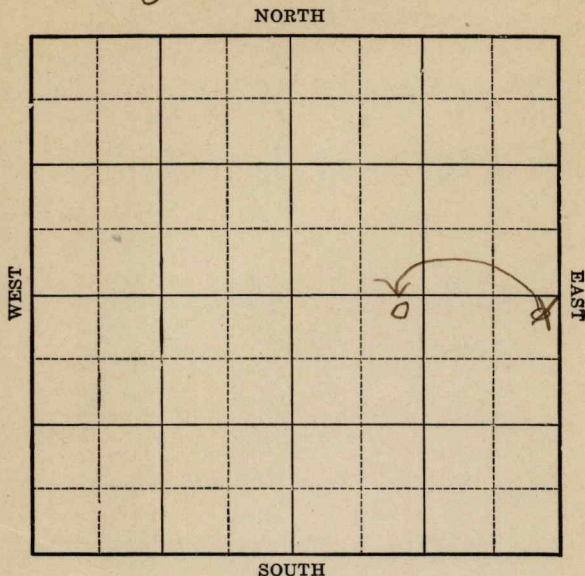

Location _____

Drilling Remarks _____

RECORD

Cased _____ in. _____ ft.

Sand _____

Gas _____

Oil _____

Total Depth _____

Rig Up _____

Drilling Remarks _____

PRODUCTION

1st 24 hrs. Nat. _____

1st. 24 hrs. after shot _____


Gas _____ cu. ft.

Dry Hole _____

Abandoned _____

Map No. K Sec. 22 Twp. 27 R. 6^EWell No. #1 Gressler Farm
Wentz et al Company200 Ft. from N. Line

Ft. from S. Line

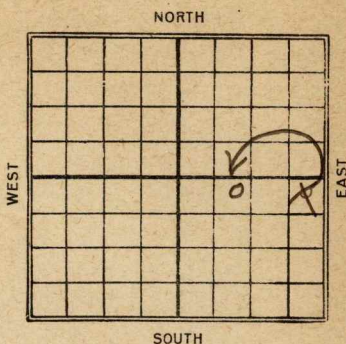~~200~~ Ft. from E. Line1120 Ft. from W. Line

C

Date	REPORT
1924	
11/19	Timbers
12/17	spudding
1925	
1/21	S.D. 450
5/29	Dry 2400
6/5	U.R. 6" T.D. 2430
6/12	S.D. 2609
6/19	Dry 2640
6/26	log tools 2700
7/3	
7/10	T.D. 2740 C.O.
7/17	5 " @ 2740
7/24	S.D. 2740 - William 5"
7/31	U.R. 5" 2740
8/7	
8/14	
8/20	
8/27	
9/3	
9/11	T.D. 2740 hole clean & U.R.
9/16	T.D. 2740 S.R. 6" log

9/24 - Same

10/1 —

10/8 Sand 2743-2745 Htg 2746

10/16 S.D. 2745'

10/22 S.D. 2760

10/29 S.D. @ 2767

11/6 —

11/13 —

11/19 —

11/27 —

12/3 Tap line 2744 S/D 2767

12/10 —

12/23 - Abandoned 3153

11
 Map No. **KANSAS** Sec. 22 Twp. 27 R. 6 **E**
Well No. #1 GesslerWentz et al Company

Contractor

FIRST REPORT

200 Ft. from N. Line

_____ Ft. from S. Line

200 Ft. from E. Line

_____ Ft. from W. Line

SECTION PLAT

			o

Location _____

Rig up _____

Drilling and Remarks:

Timbers

RECORD

Cased _____ in., _____ ft.

Sand _____

Gas _____

Oil _____

Total Depth _____

PRODUCTION

1st 24 hrs. Nat. _____

1st 24 hrs. after shot _____

Gas _____ Cu. Ft.

Dry Hole _____

Abandoned _____

Date

NOV 19 1924

M. A. BENEAR

192

Scout

11 15400 Sec. 22 Twp. 27 R. 6
 Map No. -----

 Well No. 1 156 156 N

----- Company

----- Contractor

CORRECTION


200 ----- Ft. from N. Line

----- Ft. from S. Line

----- Ft. from E. Line

1120 ----- Ft. from W. Line

SECTION PLAT

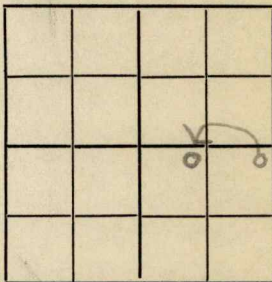

Location -----

Rig up -----

Drilling and Remarks:

 Del'y by tools
 at 2338'

CORRECTION

chg location to above

RECORD

Cased ----- in., ----- ft.

Sand -----

Gas -----

Oil -----

Total Depth -----

PRODUCTION

1st 24 hrs. Nat. -----

1st 24 hrs. after shot -----

Gas ----- Cu. Ft.

Dry Hole -----

Abandoned -----

Date

MAY 15 1925

192

 CHAS. L. SHERWOOD
 Scout

Bother Co

Map No. KANSAS Sec. 22 Twp. 27 R. 6Well No. 1 Wentz et al Company _____

Contractor _____

ABANDONED

SECTION PLAT

		o	

200 Ft. from N. Line

_____ Ft. from S. Line

_____ Ft. from E. Line

1120 Ft. from W. Line

COMPLETED

Location _____

Rig up _____

Drilling and Remarks:

Run 2743-45 DryTap line 2744'Tap 2nd blank 3150'AFW 3153'Dry & who

RECORD

Cased _____ in., _____ ft.

Sand _____

Gas _____

Oil _____

Total Depth 3153'

PRODUCTION

1st 24 hrs. Nat. _____

1st 24 hrs. after shot _____

Gas _____ Cu. Ft.

Dry Hole ☒Abandoned ☒

Date

DEC 23 1925

CHAS. L. SHERWOOD

192

Scout