
FORM 51 25M 3-49 PETROL Graham Co. Kansas

Section 14 Township 7 Range 22W

Well No. #1 Worcester

Company Ingraham & Graham

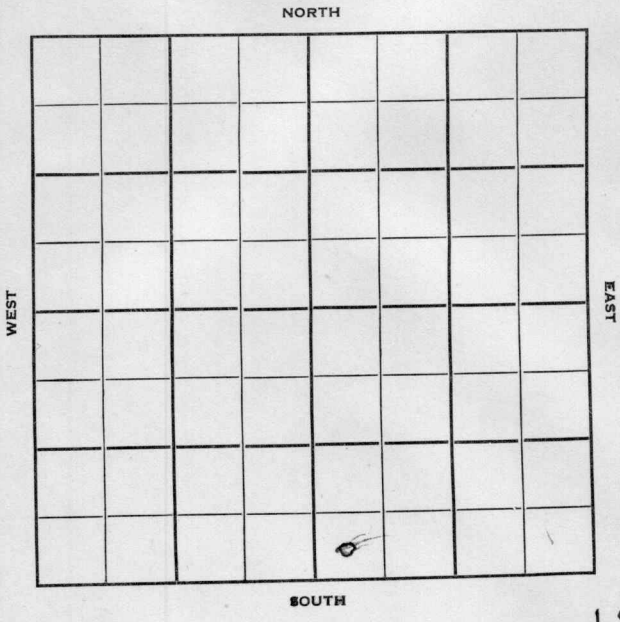

15

FORM 252-B
10M 9-49 PETROL

KANSAS Graham

Sec. 14 Twp. 7 R. 22-W

Well No. #1 Worcester Farm

Ingraham & Graham Company

Hartman Drlg. Contractor

Wildcat

Ft. from N. Line


330 Ft. from S. Line

Ft. from E. Line

330 Ft. from W. Line

SW SW SE

Shell DHM

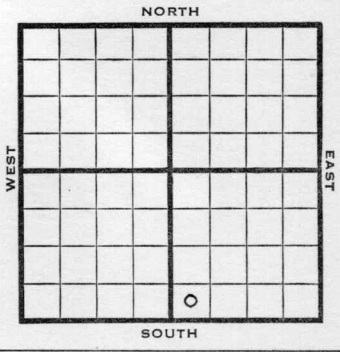

1950	Elv 2209	REPORT
7/19	Spud 7-14-50	
	8" @ 151	
	Anhy 1795	Heeb 3400
	Lans 3437	
	Drlg 3477	
7/26	8" @ 151	
	Anhy 1795	Heeb 3408
	Lans 3449	
	DST 3511-32 opn 1 hr rec 325' SW	
	Cong 3734	Arb 3753
	DST 3755-65 opn 30 min rec 15' socm	
	DST 3755-71 opn ½ hr rec 30' mud	
	TD 3805	
	D&A	

ABANDONED

Form 26 200 Bks. 11-49 Petrol

Wildcat

Kansas

Map No. _____ Sec. 14 Twp. 7 R. 22W

Well No. 1 Worcester

Ingraham & Graham Company

Hartman Drlg. Contractor

SW SW S E

SECTION PLAT

_____ Ft. from N. Line

330 Ft. from S. Line

_____ Ft. from E. Line

330 Ft. from W. Line



Graham County

Shell DHM

Location _____

Rig up _____

Drilling and Remarks:

Spud 7-14-50

8" @ 151

Anhy 1795

Heeb. 3400

Lans. 3437

drlg. 3477

RECORD

Cased _____ in., _____ ft.

Sand _____

Gas _____

Oil _____

Total Depth _____

PRODUCTION

1st 24 hrs. Nat. _____

1st 24 hrs. after shot _____

Gas _____ Cu. Ft.

Dry Hole _____

Abandoned _____

Date

JUL 19 1950

19 _____

J. E. TYLER Scout

Form 26 200 Bks. 11-49 Petrol

Kansas

Wildcat

Map No. _____ Sec. 14 Twp. 7 R. 22W

Well No. 1 Worcester


Ingraham & Graham Company

_____ Contractor

SW SW SE

El. 2209

SECTION PLAT

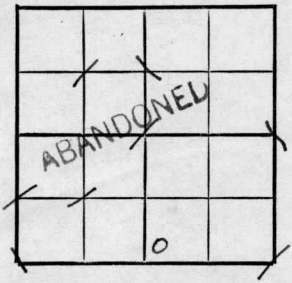

_____ Ft. from N. Line

330 Ft. from S. Line

_____ Ft. from E. Line

330 Ft. from W. Line

Graham County

Location _____

Rig up _____

Drilling and Remarks:

8" @ 151

Anhy 1795

Heeb. 3408

Lans. 3449

DST 3511-32

open 1 hr.

Rec. 225' salt water

RECORD

Cased _____ in., _____ ft.

Sand _____

Gas _____

Oil _____

Total Depth 3805

PRODUCTION

1st 24 hrs. Nat. _____

1st 24 hrs. after shot _____

Gas _____ Cu. Ft.

Dry Hole _____

Abandoned _____

Date

JUL 26 1950 19

J. E. TYRA Scout

Cong. 3734

Arb. 3753

DST 3755-65

open 30 min.

Rec. 15' socm

DST 3755-71

open 1/2 hr.

Rec. 30' mud

TD 3805

D & A

AUG 1 1950

Scout Cards
Land Small Map
Land Wall Map
Tracings
France Map
Pierce Map
Misc.

