


DX 78-1 Russell

KANSAS

Section 6 Township 14 Range 11W

Well No. #1 Biesel

Company Frontier Oil

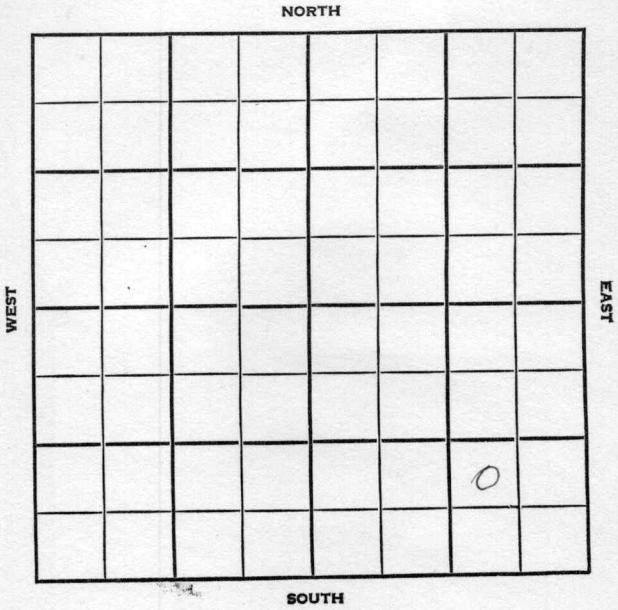

Russell

KANSAS

SEC.

6

TWP.

14

R.

11W

WELL NO.

#1 Biesel

FARM

COMPANY

Frontier Oil

CONTRACTOR

Stearns

WILDCAT


FT. FROM N. LINE

FT. FROM S. LINE

FT. FROM E. LINE

FT. FROM W. LINE

NW SE SW SE

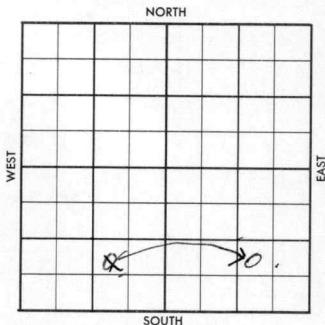

Mid-States - FO

1956

ELEVATION

1789 EL

REPORT

6-6

Comm. 6-1-56
8" @ 165 w/300
Drlg. 1500

6-13

DST 2936-50 (60) rec. 32' 0 & GCM
30' mcsw
BHP 790 (20) Cgl.
TD 3310'
L. 2913', Cgl. 3242', A. 3257',
Log: H. 2811', Tr. 2831', Dg. 2847',
B.I. 2897', L. 2913', A. 3253'

D & A ABANDONED

County Russell Elev. _____
 Sec. 6 Twp. 14 Rge. 11W
 Company Frontier Oil
 Farm Name Biesel No. 1

TOPS	DEPTH	LOG	DATUM
Anh.			
TP.			
H.			
Tr.			
Dg.			
Bl.			
L.			
M.C.			
B.K.C.			
Ce.			
C.			
M.			
M.			
K.			
Mz.			
Me.			
V.			
S.			
S.			
A.			
R.			
PE.			
G.			
T.D.			

Loc. in Sec. NW SE
SE
 Geol. _____
 Contr. Stearns
 Pool Wildcat

FIRST REPORT		JUN 6 '56	
		0	

Date Comm. 6-1-56 Mid-States - FO
8" @ 165/300 drlg. 1500

(Large handwritten scribble)

JUN 1 1 1956

R. G.

Co.
 Lse.
 No.
 Sec.
 T.
 R.

CORRECTION

County Russell Elev. 1789
 Sec. 6 Twp. 14 Rge. 11W
 Company Frontier Oil
 FarmName Biesel No. 1

TOPS	DEPTH	LOG	DATUM
Anh.			
TP.			
H.		2811	
Tr.		2831	
Dg.		2847	
Bl.		2897	
L.	2913	2913	
K.C.			
B.K.C.			
Ce.	3242	3240	
C.			
M.			
M.			
K.			
Mz.			
Ma.			
V.			
S.			
S.			
A.	3257	3253	
R.			
Pe.			
G.			
T.D.	3310		

Loc. in Sec. NW SE S1 SE

Geol. _____
 Contr. _____
 Stearns
 Pool
 Wildcat

ABANDONED

JUN 13 1956

Date Comm. 6-1-56 Mid-States - PO

8" @ 165/300 drlg. 1500

JUN 13 1956

PST 2936-50 (60) loc 32' OAGCM

30' MCSW BHP 790 (20) gal

TP 3310

D.C. A

Co.
 Sec.
 No.
 Sec.
 T.
 R.