


Saline

KANSAS

SECTION 32 TOWNSHIP 14S RANGE 2W

WELL NO. #1 O'Conner

COMPANY Cal Jones

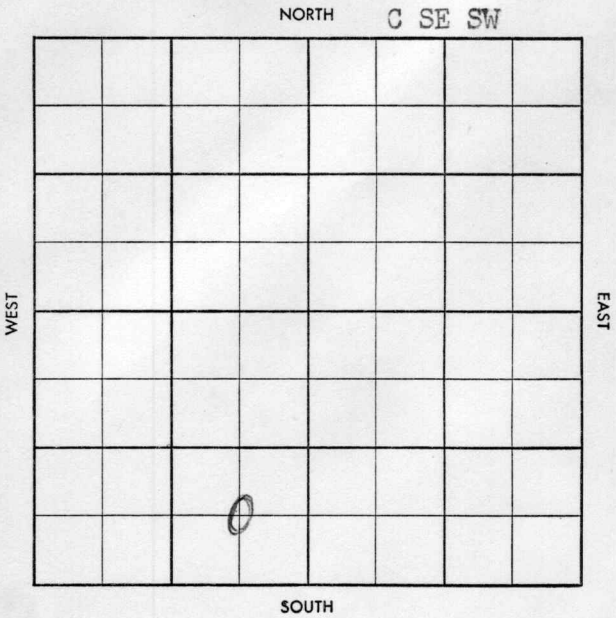



County Saline Elev. _____
 Sec. 32 Twp. 14 Rge. 2W
 Company Cal Jones
 Farm Name O'Conner No. 1

TOPS	DEPTH	LOG	DATUM
Anh.			
Tp.			
H.			
Tr.			
Dg.			
B.L.			
L.			
K.C.			
B.K.C.			
Ce.			
C.			
M.			
M.			
K.			
Mz.			
Mq.			
V.			
S.			
S.			
A.			
R.			
Pf.			
G.			
T.D.			

Loc. in Sec. _____
C SE SW
 Geol. _____
 Contr. _____
J.A. Melland
 Pool _____
S. Saline



Date Comm. 2-15-58
8" @ 160/125 drlg. 400

Co.
Lse.
No.
Sec.
T.
R.

Farm ~~Pool~~ # 8442

Co. ~~Pool~~
Canton

Home MA 84929

S-513-B

County Saline Elev. 12390-12420
Sec. 32 Twp. 14 Rge. 2W
Company Cal Jones
Farm Name O'Conner No. 1

TOPS	DEPTH	LOG	DATUM
Anh.			
Tp.			
H.			
Tr.			
Dg.			
B.L.			
L.			
K.C.	<u>2015</u>		
B.K.C.			
Ce.			
C.			
M.	<u>2652</u>		
M.			
K.	<u>2905</u>		
Mz.	<u>Hunt 3028</u>		
Ma.	<u>3127</u>		
V.			
S.			
S.			
A.			
R.			
Pf.			
G.			
T.D.	<u>3220</u>		

Loc. in Sec. C SE SW
Geol. Dunmelland
Contr. J.A. Melland
Pool S. Saline

COMPLETE
MAY 28 '58

Date Comm. 2-15-58
8" @ 160/125 drg. 100 ft 26 50 5 1/2 3218

WOC CO CO DP
3224 TD & 4 Boph + 40' W
natural pop
MAY 14 '58 MAY 21 '58 MAY 29 '58 MAY 7 '58
+ VW

open hole 3218 - 3224