

Russell

14 12W


Form 51-5M-2-29-34703

Map No. KANSAS Sec. 5 Twp. ~~12~~ R. ~~12~~

Well No. 1- Mahoney Farm

Allison & Fitzwilliam Company

NORTH

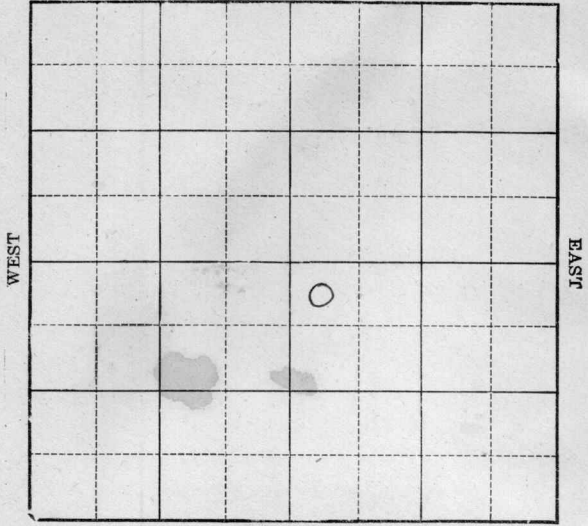

SOUTH

Location _____

Drilling Remarks _____

Rig Up _____

Drilling Remarks _____

RECORD

PRODUCTION

Cased _____ in. _____ ft.

1st 24 hrs. Nat. _____

Sand _____

1st 24 hrs. after shot _____

Gas _____

Gas _____ cu. ft.

Oil _____

Dry Hole _____

Total Depth _____


Abandoned _____

14 12^w

Map No. KANSAS Sec. 5 Twp. ~~14~~ R. ~~12^w~~

Well No. 1- Mahoney Farm
Allison & Fitzwilliam Company

330 Ft. from N. Line
____ Ft. from S. Line
____ Ft. from E. Line
330 Ft. from W. Line

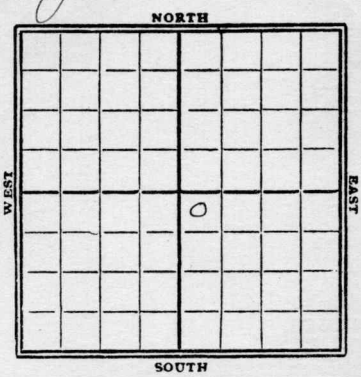

1929

Date	REPORT
3/20	Location
3/27	Rig
4/3	—
4/10	—
4/17	Rig
4/24	S.D. 250'
5/1	Wrlg 488
5/8	" 1130'
5/14	10" - 1500'
5/22	Wrlg 2240'
5/29	S.D. 2250'
6/5	Wrlg 2440'
6/12	" 2650'
6/21	Top Oswald Id. 2952 ²⁹⁸⁵ show oil - Set. 6"
6/26	6" - 2985 Wrlg 3055
7/2	Sandy line 3210-3218 HPW shut down
7/10	T.D. 3218' - VTR 6"
7/17	S.D. 3218'
7/24	—
7/31	Top sand 3372 - W.R. 6"

8/7- Wrlg 3385' 498895

8/14- S.D. 3385'

8-21 aban

8/21- TD 3387'

Abandoned

Russell
MAP No. KANSAS SEC. 5 TWP. 12 R. 14 W

WELL No. Wagon

Allison & Fitz Williams & Co COMPANY

CONTRACTOR

SECTION PLAT

		0	

330 FT. FROM N. LINE

_____ FT. FROM S. LINE

_____ FT. FROM E. LINE

330 FT. FROM W. LINE

FIRST REPORTS

LOCATION ✓

RIG UP _____

DRILLING AND REMARKS:

RECORD

CASED _____ IN. _____ FT.

SAND _____

GAS _____

OIL _____

TOTAL DEPTH _____

PRODUCTION

1ST 24 HRS. NAT. _____

1ST 24 HRS. AFTER SHOT _____

GAS _____ CU. FT.

DRY HOLE _____

ABANDONED _____

DATE

MAY 20 1929 192

S. J. LEWIS SCOUT

Map No. *Russell* **KANSAS** Sec. *5* Twp. *17* R. *12W*

Well No. *1 Mahoney*

William & Fitzwilliams Company

Contractor

SECTION PLAT

930 Ft. from N. Line

..... Ft. from S. Line

..... Ft. from E. Line

930 Ft. from W. Line

		0	

CORRECTION

Location.....

Rig up.....

Drilling and Remarks:

Repeated
5-12-14 W

RECORD

Cased..... in., ft.

Sand.....

Gas.....

Oil.....

Total Depth.....

PRODUCTION

1st 24 hrs. Nat.....

1st 24 hrs. after shot.....

Gas..... Cu. Ft.

Dry Hole.....

Abandoned.....

Date

APR 10 1920

S. J. LEWIS

Scout

Russell
 Map No. **KANSAS** Sec. 5 Twp. 14 R. 12W

Well No. 1 Mahoney

Allison & Fitzwilliams Company

Contractor

SECTION PLAT

		0	

330 Ft. from N. Line

_____ Ft. from S. Line

_____ Ft. from E. Line

330 Ft. from W. Line

ABANDONED

Location _____

Rig up _____

Drilling and Remarks:

RECORD

Cased _____ in., _____ ft.

Sand _____

Gas _____

Oil _____

Total Depth 3387

PRODUCTION

1st 24 hrs. Nat. _____

1st 24 hrs. after shot _____

Gas _____ Cu. Ft.

Dry Hole _____

Abandoned _____

Date

AUG 27 1919

S. J. LEWIS

Scout