


Russell

KANSAS

SECTION 15 TOWNSHIP # 14 S RANGE 12W

WELL NO. #3 Beizel

COMPANY Thomas H. Allen

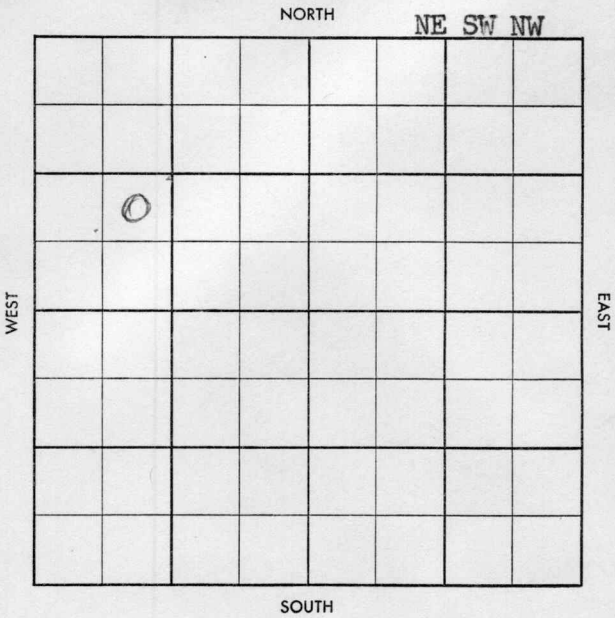

S-513-B

Twp. ~~X~~ Pool ~~X~~
Co. ~~X~~ Facet ~~13~~

County Russell Elev. _____
Sec. 15 Twp. 14 Rge. 12W
Company Thomas H. Allan
Farm Name Beizel No. 3

TOPS	DEPTH	LOG	DATUM
Anh.			
Tp.			
H.			
Tr.			
Dg.			
B.L.			
L.			
K.C.			
B.K.C.			
Ce.			
C.			
M.			
M.			
K.			
Mz.			
Mq.			
V.			
S.			
S.			
A.			
R.			
Pf.			
G.			
T.D.			

Loc. in Sec. NE SW NW

Geol. _____
Contr. Co. Tools

Pool Beizel



Date Comm. _____
location

Co.
Lse.
No.
Sec.
T.
R.

Twp. X Pool X
Co. X Facet X

S-513-B

County Russell Elev. 1792 RB 17900F
 Sec. 15 Twp. 14 Rge. 12W
 Company Thomas H. Allan
 Farm Name Beizel No. 3

TOPS	DEPTH	LOG	DATUM
Anh.			
Tp.			
H.	<u>2820</u>		
Tr.			
Dg.			
B.L.			
L.	<u>2906</u>		
K.C.			
B.K.C.			
Ce.			
C.			
M.			
M.			
K.			
Mz.			
Mq.			
V.			
S.			
S.			
A.	<u>3267</u>		
R.			
Pf.			
G.			
T.D.	<u>3274</u>		

Loc. in Sec. NE SW NW
 Geol. _____
 Contr. _____
 Co. Tools _____
 Pool Beizel

APR 30 '58
 COMPLETE

Date Comm. 3-26-58
 location APR 2 '58 8" 45' Ø 2765
 APR 9 '58 no log 5 1/2" 3274
 CO APR 15 '58 Ø 3284 \$ 1/2 BFPH
20% W NT free NOBEL 1 1/2
\$ 1 1/2 BFPH 20% W NT
 APR 23 '58 \$ 26 1/2 130 + 20% W 16 hrs
set 40 130 20% W APR 30 '58 P 40 130 W
+ 20% W
 ⌘