
Russell

KANSAS

SECTION 15 TOWNSHIP 14S RANGE 12W

WELL NO. #2 Beisel

COMPANY Thomas H. Allan

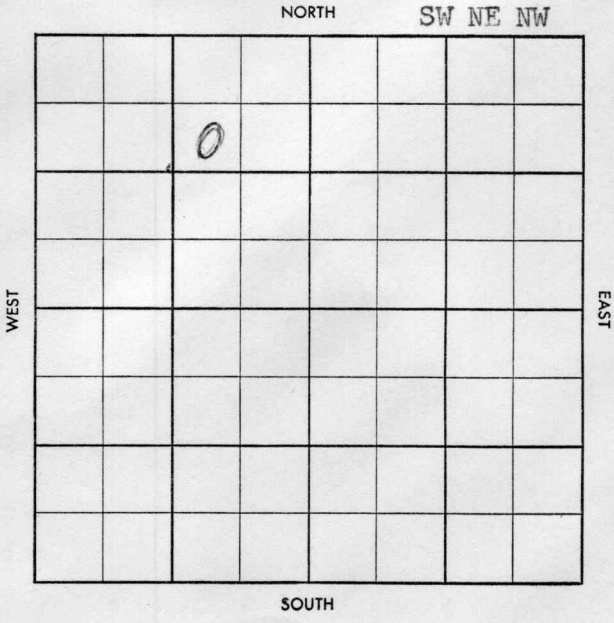


FORM 504-3 SUNRAY

S-513-B

13

County Russell Elev.

Sec. 15 Twp. 14 Rge. 12W

Company Thomas H. Allan

Farm Name Beisel No. 2

| TOPS | DEPTH | LOG | DATUM |
|---|---|---|---|
| Anh. | 688 | | |
| Tp. | | | |
| H. | | | |
| Tr. | | | |
| Dg. | | | |
| B. L. | | | |
| L. | | | |
| K.C. | | | |
| B.K.C. | | | |
| Ce. | | | |
| C. | | | |
| M. | | | |
| M. | | | |
| K. | | | |
| Mz. | | | |
| Mq. | | | |
| V. | | | |
| S. | | | |
| S. | | | |
| A. | | | |
| R. | | | |
| Pf. | | | |
| G. | | | |
| T.D. | | | |

Loc. in Sec. SW NE NW

Geol.

Contr.

Pool Beisel




Date Comm. 2-15-58

8" @ 470/320 drlg. 1482

Co. Lse. No. Sec. T. R.

Twp. X Pool X

Co. X Facet X

S-513-B

County Russell Elev. 1806 DF 1811 KB

Sec. 15 Twp. 14 Rge. 12W

Company Thomas H. Allan

Farm Name Beisel No. 2

| TOPS | DEPTH | LOG | DATUM |
|---|---|---|---|
| Anh. | 688 | | |
| Tp. | | | |
| H. | | | |
| Tr. | | | |
| Dg. | | | |
| B. L. | | | |
| L. | 2918 | | |
| K.C. | | | |
| B.K.C. | | | |
| Ce. | | | |
| C. sd | 3249 | | |
| M. | | | |
| M. | | | |
| K. | | | |
| Mz. | | | |
| Mq. | | | |
| V. | | | |
| S. | | | |
| S. | | | |
| A. | 3283 | | |
| R. | | | |
| Pf. | | | |
| G. | | | |
| T.D. | 3288 | | |

Loc. in Sec. SW NE NW

Geol.

Contr.

Pool Beisel

MAY 7 '58

COMPLETE

Date Comm. 2-15-58

8" @ 470/320 drlg. 1482 FEB 26 '58 5½"

3288/125 MAR 5 '58 MICT MAR 12 '58 PD

3302 TD NS PB 3280 50/3249

-53 $ ½ BOPH 4 hrs NW visi

Frac $ 5.12 BO 6 hrs MAR 19 '58

MAR 26 '58 APR 2 '58 APR 9 '58 APR 16 '58 APR 23 '58 $ 6 BO

PH NW 8 hrs pop pot P 144 BOPD

APR 30 '58 new pay in Conql Pr 34°

MAY 7 '58