

KANSAS

Form 51—5M—7-39—Palace

Cowley

Section 33 Township 31 Range 3-E

Well No. #1 Faust

Company Saco Oil

Miscellaneous

NORTH

WEST

EAST

						0	


SOUTH

Sec. 33 Twp. 31 R. 3-EWell No. #1 Faust FarmSaco Oil Company

(Misc)

990 Ft. from N. Line Ft. from S. Line990 Ft. from E. Line Ft. from W. Line

Elev. 1217

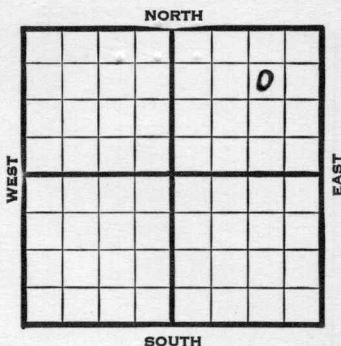

1940	REPORT
5/8	Surface hole.
5/16	" "
5/23	" "
5/29	20" - 47' Drlg. 430'
6/6	Drlg. 703'
6/13	" "
6/20	15" - 439' 12" - 1352'
	Drlg. 1800'
6/27	10" - 1840' 8" - 2100'
	Drlg. 2205'
7/3	2390' U.R. 8".
7/11	8" - 2350' K.C. 2524-2635'
	Drlg. 2920'
7/18	Miss. 3069' 7" - 3072'
	Drlg. 3143'
	OVER

1940

7/24

Arb. 3350'

5" - 3350'

T.D. 3368'

H.F.W.

ABANDONED

Map No. / Sec. 33 Twp. 31 R. 3EWell No. 1 Faust

Saco Oil

Company

FIRST REPORT

Contractor

SECTION PLAT

SW NE NE

			o

990 Ft. from N. Line Ft. from S. Line990 Ft. from E. Line Ft. from W. Line

Miscellaneous

Location Rig up

Drilling and Remarks:

Surface Hole

RECORD

Cased in., ft.Sand Gas Oil Total Depth

PRODUCTION

1st 24 hrs. Nat. 1st 24 hrs. after shot Gas Cu. Ft.Dry Hole Abandoned

Date

MAY 8 1940 19

S. J. LEWIS

Scout

Map No. 1 Sec. 33 Twp. 31 R. 3EWell No. 1 FaustSaco Oil

Company

Contractor

ABANDONED

SECTION PLAT

			6

SW NE NE

990 Ft. from N. Line

Ft. from S. Line

990 Ft. from E. Line

Ft. from W. Line

MISCELLANEOUS

Location

Rig up

Drilling and Remarks:

*Oil 3350**5" C 3350**NFW*

RECORD

Cased _____ in., _____ ft.

Sand _____

Gas _____

Oil _____

Total Depth 8368

PRODUCTION

1st 24 hrs. Nat. _____

1st 24 hrs. after shot _____

Gas _____ Cu. Ft.

Dry Hole _____

Abandoned _____

Date

JUL 24 1940

19

S. J. LEWIS Scout