


Section 33 Township 31 Range 3-E

Well Number 4 McKinley "A"

Company Lloyd Frost & Study

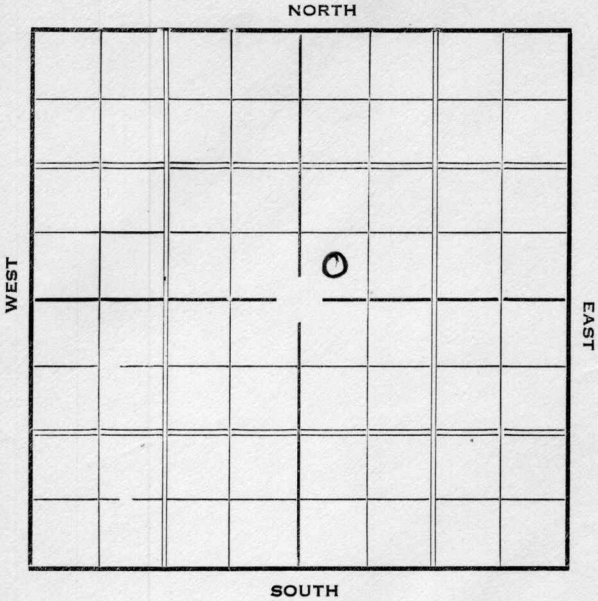


Sec. 33 Twp. 31 R. 3E

Well No. 4 McKinley "A" Farm  
Lloyd Frost & Study Company

         Ft. from N. Line  
330 Ft. from S. Line  
         Ft. from E. Line  
330 Ft. from W. Line

*Elev. 1187*

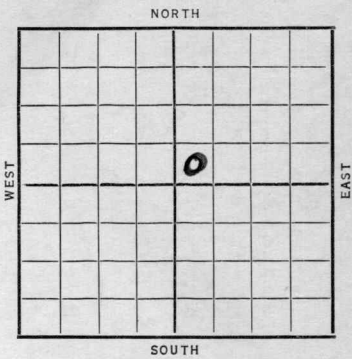

Date 1937	REPORT
1/27	12" @ 67
	Drlg. 555
2/4	Drlg. 2635'.
2/11	Drlg. 3180'.
2/18	6" @ 3300'. RUST.
2/26	Sil. 3271'. TD 3289'
	Flowed 3084 bbls.
3/3	Sil. 3271'.
	T. D. 3289'.
	Flow 3084 natural.
	<b>COMPLETED</b>

Map No. 1 Sec. 33 Twp. 31 R. 3E

Well No. 4 Mc Kinley "A"

Lloyd Frost & Study Company  
Contractor

SECTION PLAT

		6	

\_\_\_\_\_ Ft. from N. Line  
330 Ft. from S. Line  
 \_\_\_\_\_ Ft. from E. Line  
330 Ft. from W. Line

FIRST REPORT

Location \_\_\_\_\_

Rig up \_\_\_\_\_

Drilling and Remarks:

12" @ 67  
July 555

RECORD

Cased \_\_\_\_\_ in., \_\_\_\_\_ ft.  
 Sand \_\_\_\_\_  
 Gas \_\_\_\_\_  
 Oil \_\_\_\_\_  
 Total Depth \_\_\_\_\_

PRODUCTION

1st 24 hrs. Nat. \_\_\_\_\_  
 1st 24 hrs. after shot \_\_\_\_\_  
 Gas \_\_\_\_\_ Cu. Ft.  
 Dry Hole \_\_\_\_\_  
 Abandoned \_\_\_\_\_

Date

JAN 27 1937

Map No. J 1 Sec. 33 Twp. 31 R. 22

Well No. 4 Mc Kinley "A"

Lloyd, Frost & Study Company  
Contractor

SECTION PLAT

\_\_\_\_\_ Ft. from N. Line

330 Ft. from S. Line

\_\_\_\_\_ Ft. from E. Line

330 Ft. from W. Line

		0	

COMPLETED

Location \_\_\_\_\_

Rig up \_\_\_\_\_

Drilling and Remarks:

Sec 3271  
Flow 3084  
natural

RECORD

Cased \_\_\_\_\_ in., \_\_\_\_\_ ft.

Sand \_\_\_\_\_

Gas \_\_\_\_\_

Oil \_\_\_\_\_

Total Depth 3289

PRODUCTION

1st 24 hrs. Nat. \_\_\_\_\_

1st 24 hrs. after shot \_\_\_\_\_

Gas \_\_\_\_\_ Cu. Ft.

Dry Hole \_\_\_\_\_

Abandoned \_\_\_\_\_

Date

MAR 3 1937 19

S. J. LEWIS Scout