


Section 33 Township 31 Range 3E

Well No. 6 McKinley "A" twin #4

Company Barnett Drlg.

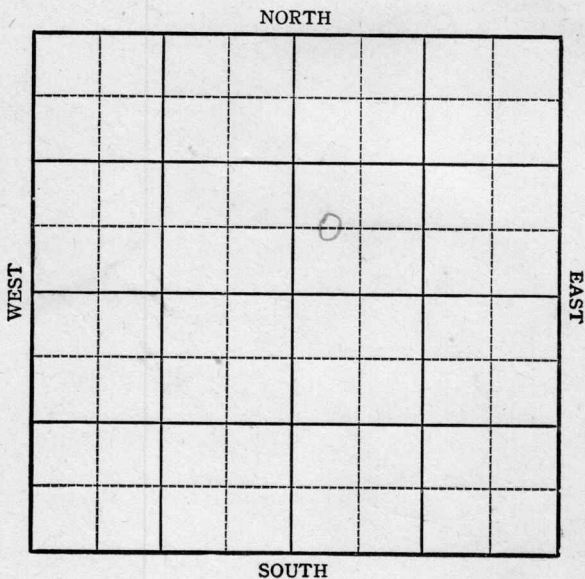

Sec. 33 Twp. 31 R. 3E

Well No. 6 McKinley "A" twin #4 Farm

Barnett Drlg. Company

Miscellaneous


 Ft. from N. Line

590 Ft. from S. Line

 Ft. from E. Line

330 Ft. from W. Line

C W L SW NE

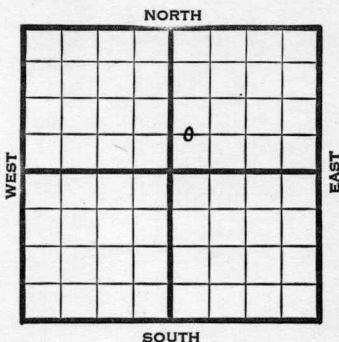

1945

REPORT

5/16

Location

5/24

Drlg. 2012

5/31

Stalnacker 2058

TD 2064' SO

5" @ 2058' RUST

6/8

TD 2086 20 qts 2065-80 CO

6/20

Stalnacker 2058

5" @ 2058

TD 2086

30 qts. 2062-2078

Pump 15 Pot.

Grav. 37.0

COMPLETED

Kansas Pool Name Miscellaneous

Map No. 1 Sec. 33 Twp. 31 R. 3E

Well No. 6 McKinley "A" twin #4

Barnett Drlg. Company

IRST REPORT

Contractor

C W L SW NE

SECTION PLAT

		o	

 Ft. from N. Line

590 Ft. from S. Line

 Ft. from E. Line

330 Ft. from W. Line

Cowley

Location X

Rig up

Drilling and Remarks:

RECORD

Cased in., ft.

Sand

Gas

Oil

Total Depth

PRODUCTION

1st 24 hrs. Nat.

1st 24 hrs. after shot

Gas Cu. Ft.

Dry Hole

Abandoned

Date

MAY 16 1945 19

S. J. LEWIS

Scout

Kansas Pool Name Miscellaneous

Map No. _____ Sec. 33 Twp. 31 R. 3E

Well No. 6 McKinley "A" twin #4

Barnett Drlg. Company

COMPLETED

Contractor

C W L SW NE

SECTION PLAT

		o	

_____ Ft. from N. Line

590 Ft. from S. Line

_____ Ft. from E. Line

330 Ft. from W. Line

Cowley County

Location _____

Rig up _____

Drilling and Remarks:

Stalnac 2058

5" @ 2058

309 to 2062-78

Pump 15 Rod

37 = 42

RECORD

Cased _____ in., _____ ft.

Sand _____

Gas _____

Oil _____

Total Depth 2076

PRODUCTION

1st 24 hrs. Nat. _____

1st 24 hrs. after shot _____

Gas _____ Cu. Ft.

Dry Hole _____

Abandoned _____

Date

JUN 20 1945 19

S. J. LEWIS Scout