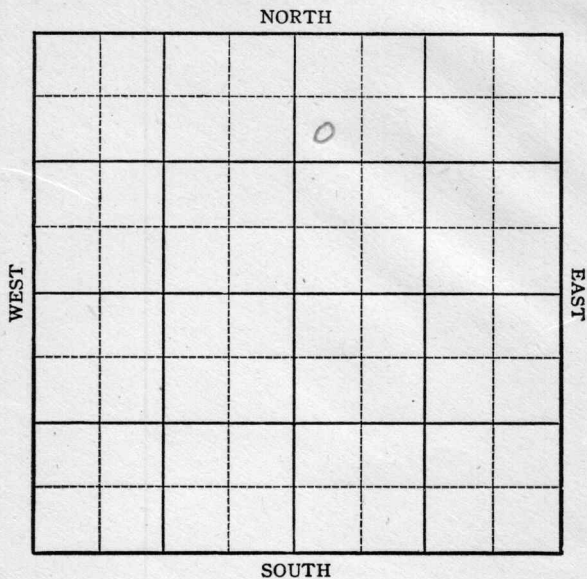


KANSAS

Cowley county

Section 33 Township 31 Range 3-EWell No. #8, McKinley "A"Company Barnett Drilling Company

KANSAS

Cowley

Sec. 33 Twp. 31 R. 3E

Well No. 8 McKinley "A" (TWIN) Farm

Barnett Drlg Company


Miscellaneous

1000 Ft. from N. Line

Ft. from S. Line

Ft. from E. Line

450 Ft. from W. Line

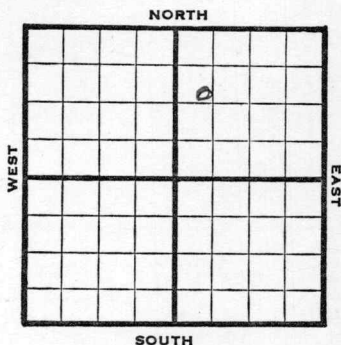

SW NW NE

| 1946  | Elev. 1195' REPORT                                                          |
|-------|-----------------------------------------------------------------------------|
| 11/20 | 8" @ 60'<br>Drlg 100'                                                       |
| 11/27 | Drlg 1675'                                                                  |
| 12/3  | Stal 2081'<br>TD 2093'<br>7" @ 2080 SO                                      |
| 12/10 | 50 qts 2083-93 fsg                                                          |
| 12/17 | " "                                                                         |
| 1947  |                                                                             |
| 1/2   | Stal 2081'<br>7" @ 2080'<br>TD 2093'<br>50 qts<br>Pump 15 POT<br>38.6 Grav. |

COMPLETED

Map No. 1 Sec. 33 Twp. 31 R. 3E

Well No. 8 McKinley "A"

Barnett Drlg. Company

FIRST REPORT Contractor

SW NW NE

SECTION PLAT

1000 Ft. from N. Line

       Ft. from S. Line

       Ft. from E. Line

450 Ft. from W. Line

|  |  |   |  |
|--|--|---|--|
|  |  | 0 |  |
|  |  |   |  |
|  |  |   |  |
|  |  |   |  |

Cowley County

Location                                 

Rig up                                 

Drilling and Remarks:

twin well  
8" @ 60  
drlg. 100'

RECORD

Cased        in.,        ft.

Sand                                 

Gas                                 

Oil                                 

Total Depth                                 

PRODUCTION

1st 24 hrs. Nat.                                 

1st 24 hrs. after shot                                 

Gas                                  Cu. Ft.

Dry Hole                                 

Abandoned                                 

Date

NOV 20 1946 19 S. J. LEWIS Scout

Kansas

KANSAS Miscellaneous

Map No.            Sec. 33 Twp. 31 R. 3EWell No. 8 McKinley "A"Barnett Drlg. Company                                 COMPLETEDContractor                                 

SW NW NE

E11195  
SECTION PLAT1000 Ft. from N. Line           Ft. from S. Line450 Ft. from E. Line           Ft. from W. Line

Cowley County

|  |  |   |  |
|--|--|---|--|
|  |  |   |  |
|  |  | 0 |  |
|  |  |   |  |
|  |  |   |  |
|  |  |   |  |

Location                                 Rig up                                 

Drilling and Remarks:

Stal 20877" @ 2088509 to.Pump 15-10838 1/2 ft

## RECORD

Cased            in.,            ft.Sand                                 Gas                                 Oil                                 Total Depth 2093

## PRODUCTION

1st 24 hrs. Nat.                                 1st 24 hrs. after shot                                 Gas                                  Cu. Ft.Dry Hole                                 Abandoned                                 

Date

JAN 2 1947 19 S. J. LEWIS Scout