


Section 33 Township 31 Range 3-E

Well Number 3 McKinley "B"

Company Lloyd Frost & Study

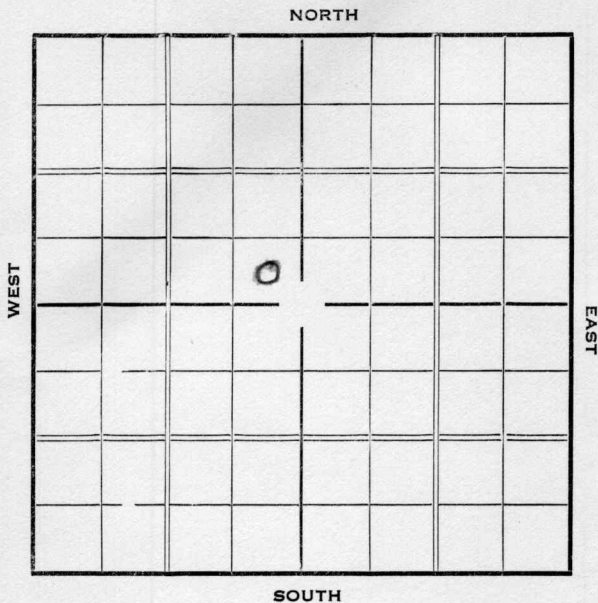


Sec. 33 Twp. 31 R. 3-E

Well No. #3 McKinley "B" Farm

Eloyd Frost & study Company

_____ Ft. from N. Line
330 Ft. from S. Line
330 Ft. from E. Line
 _____ Ft. from W. Line

Elev. 1183

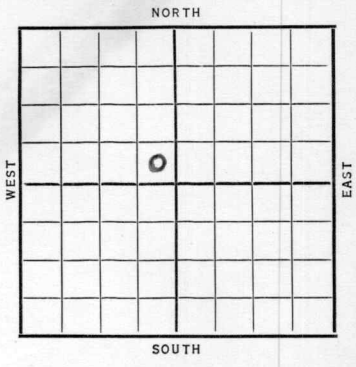

Date	REPORT
2/3	Location
2/11	" "
2/18	" "
2/26	Rigging up.
3/4	Drlg. 1607'.
3/11	Drlg. 2900'.
3/18	No report
3/24	Sil. 3248'.
	T.D. 3269'.
	Flow 2730'.
	COMPLETED

KANSAS

Map No. 1 Sec. 33 Twp. 31 R. 25

Well No. 3 McKinley "B"

Loyal Frost & Study Company
Contractor

SECTION PLAT

_____ Ft. from N. Line
330 Ft. from S. Line
330 Ft. from E. Line
 _____ Ft. from W. Line

FIRST REPORT

Location ✓

Rig up _____

Drilling and Remarks:

RECORD

Cased _____ in., _____ ft.

Sand _____

Gas _____

Oil _____

Total Depth _____

PRODUCTION

1st 24 hrs. Nat. _____

1st 24 hrs. after shot _____

Gas _____ Cu. Ft.

Dry Hole _____

Abandoned _____

Date

FEB 3 1937

KANSAS *Cowley*

Map No. 1 Sec. 33 Twp. 31 R. 3E

Well No. 3 McKeiley "B"

Lloyd, Frost & Study Company
Contractor

SECTION PLAT

_____ Ft. from N. Line
330 Ft. from S. Line
330 Ft. from E. Line
_____ Ft. from W. Line

COMPLETED

Location _____

Rig up _____

Drilling and Remarks:

Sil 3248
Flow 2730

RECORD

Cased _____ in., _____ ft.
Sand _____
Gas _____
Oil _____
Total Depth 3269

PRODUCTION

1st 24 hrs. Nat. _____
1st 24 hrs. after shot _____
Gas _____ Cu. Ft.
Dry Hole _____
Abandoned _____

Date

MAR 24 1937 19 _____

S. J. LEWIS Scout