


Section 33 Township 31 Range 3-E

Well Number 1 Carson

Company Lloyd Frost & Study

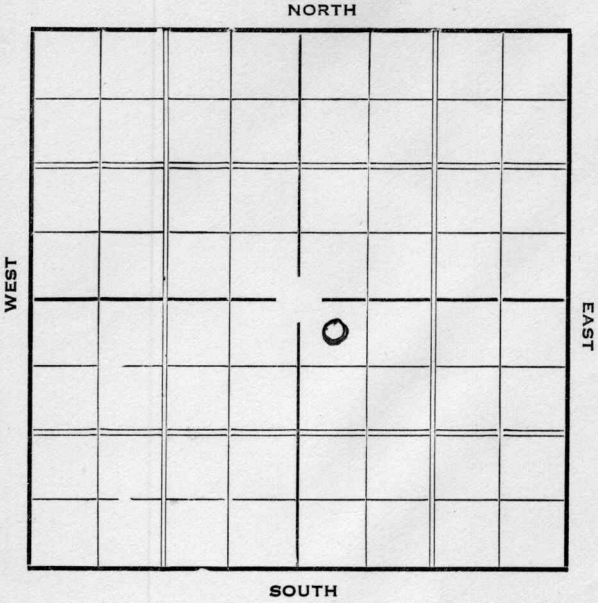

Sec. 33 Twp. 31 R. 3-E

Well No. #1 Carson Farm
Lloyd Frost & Study Company


330 Ft. from N. Line

_____ Ft. from S. Line

330 Ft. from E. Line

_____ Ft. from W. Line

Elev. 1185

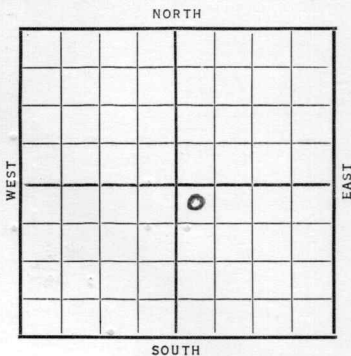

Date	REPORT
1937 3/3	Location
3/11	Cellar
3/18	"
3/25	"
4/2	"
4/8	"
4/16	12" @ 87'. Drlg. 965'.
4/23	Drlg. 2200'.
4/30	Drlg. 3005'.
5/7	Stalnaker 2054'. K.C. 2465'. S.O. 2544'. Fsg. 3138'.
5/14	7" @ 3250'. T.D. 3255'. RUST.
	OVER

1937

5/19 7" @ 3250'.

Sil. 3263'.

T.D. 3280'.

Flowed, Pot. 2714 bbls. 24
hours.

COMPLETED

Map No. 1 Sec. 33 Twp. 31 R. 31

Well No. 1 Carson

Lloyd Frost & Steady Company
Contractor

SECTION PLAT

330 Ft. from N. Line

_____ Ft. from S. Line

330 Ft. from E. Line

_____ Ft. from W. Line

		0	

FIRST REPORT

Location

Rig up _____

Drilling and Remarks:

RECORD

Cased _____ in., _____ ft.

Sand _____

Gas _____

Oil _____

Total Depth _____

PRODUCTION

1st 24 hrs. Nat. _____

1st 24 hrs. after shot _____

Gas _____ Cu. Ft.

Dry Hole _____

Abandoned _____

Date

MAR 3 1937 19

S. J. LEWIS Scout

Cowley KANSAS

Map No. 1 Sec. 33 Twp. 31 R. 3E

Well No. 1-Carson

Lloyd, Frost & Study Company
Contractor

COMPLETED

SECTION PLAT

330 Ft. from N. Line
_____ Ft. from S. Line
_____ Ft. from E. Line
330 Ft. from W. Line

		0	

Location _____

Rig up _____

Drilling and Remarks:

flowed
Pot. 2714 / 24 hrs

RECORD

Cased 7 in., 3250 ft.
Sand 511 3263
Gas _____
Oil _____
Total Depth 3280

PRODUCTION

1st 24 hrs. Nat. _____
1st 24 hrs. after shot _____
Gas _____ Cu. Ft.
Dry Hole _____
Abandoned _____

Date

MAY 19 1937

19

H. D. Hatfield

Scout