


Cowley

Section 33 Township 31 Range 3-E

Well No. 1 Carson - S.W.D.

Company Lloyd Frost & Study

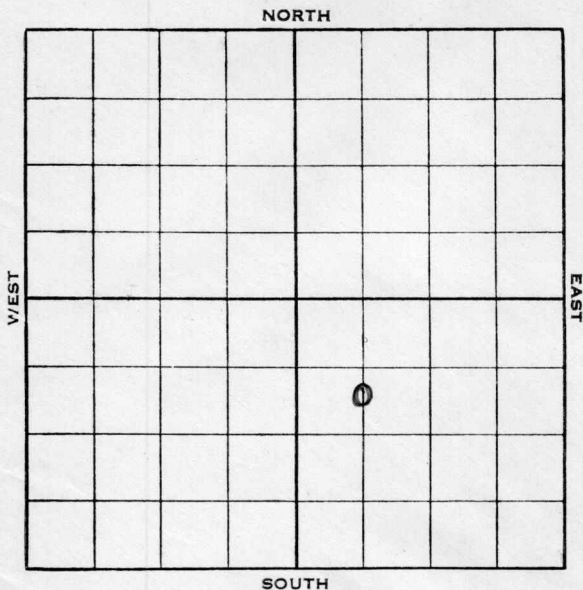

Sec. 33 Twp. 31 R. 3-E

Well No. #1 Carson - S.W.D. Farm

Lloyd, Frost & Study Company


990 Ft. from N. Line

_____ Ft. from S. Line

_____ Ft. from E. Line

660 Ft. from W. Line

Elev. 1180

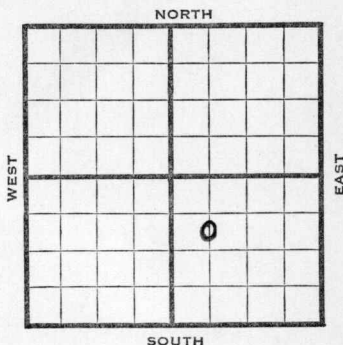

1938	REPORT
5/4	R. U.
5/12	12" @ 81'. Drllg. 1740'.
5/20	Drllg. 3075'.
5/27	Arb. 3261'. S.O. 3261 & 3290'.
	6" @ 3452'. T.D. 3452'. WOC.
6/3	" " " " " "
6/10	" " " " " "
6/17	" " " " " "
6/22	6" @ 3452'.
	Arb. 3261'.
	T. D. 4050'.
	Est. 15,000 bbls. water input per day.
	ABANDONED

Map No. / Sec. 33 Twp. 31 R. 3E

Well No. 1 Carson - S. W. D.

Lloyd Frost & Study Company

Contractor

FIRST REPORT

C S L NW SE

SECTION PLAT

990 Ft. from N. Line

Ft. from S. Line

Ft. from E. Line

660 Ft. from W. Line

		o	

Location

Rig up

Drilling and Remarks:

RU

RECORD

Cased in., ft.

Sand

Gas

Oil

Total Depth

PRODUCTION

1st 24 hrs. Nat.

1st 24 hrs. after shot

Gas Cu. Ft.

Dry Hole

Abandoned

Date

MAY 4 - 1938 19

H. D. Hatfield Scout

Cowley

KANSAS

Map No. 1 Sec. 33 Twp. 31 R. 3E

Well No. 1 Carson - SWD

Lloyd Frost & Study Company

Contractor

Abandoned

COMPLETED

SECTION PLAT

C S L NW SE

990 Ft. from N. Line

_____ Ft. from S. Line

_____ Ft. from E. Line

660 Ft. from W. Line

		0	

Salt water disposal well

Location _____

Rig up _____

Drilling and Remarks:

*Est 15,000
bbls wtr input
Per day*

RECORD

Cased 6 in., 3452 ft.

Sand Arb 3261

Gas _____

Oil _____

Total Depth 4050

PRODUCTION

1st 24 hrs. Nat. _____

1st 24 hrs. after shot _____

Gas _____ Cu. Ft.

Dry Hole _____

Abandoned _____

Date

JUN 22 1938 19

H. D. Hatfield Scout