

KANSAS

Form 51-5M-7-39-Palace


McPherson

Section 30 Township 19 Range 1-W

Well No. #2 Lewis

Company F. S. Williams et al

NORTH Ritz Canton Pool

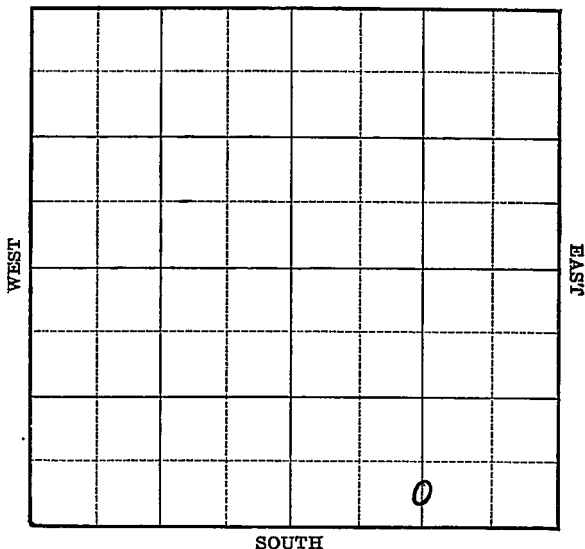

KANSAS

McPherson

Sec. 30 Twp. 19 R. 1-W

Well No. #2 Lewis Farm

F. S. Williams et al Company

(Ritz Canton)


Ft. from N. Line

330 Ft. from S. Line

1320 Ft. from E. Line

Ft. from W. Line

Elv. 1570

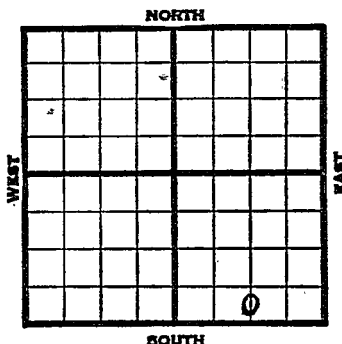

REPORT

1939

9/27	Location
------	----------

10/5	10
------	----

10/12	11
-------	----

10/19	"
-------	---

10/26	11
-------	----

11/2	11
------	----

11/9

1 1/16"

11/23 | n

11/29

12 /7	Rotary.
-------	---------

12/14

12/21	12" - 119"
-------	------------

T.D. 206 WOC.

12/28 Drlg. 1815'

1940.

1/4	Dlg.	2200'
-----	------	-------

1/11 Miss. 2935' 5" - 2941'

T.D. 2943' RUST.

1/18	Bailing mud.
------	--------------

OVER

1940

1/25

S. Gas 2944-56'

Drlg. 2957'

2/1

5" - 2944' Pay 2978-86'

T.D. 2990' 800' oil.

1000 acid. No test.

2/8

" " " "

2/14

Chat. 2935'

5" - 2944'

T.D. 2990'

1000 acid.

Pump 179 bbls.

COMPLETED

Map No. 43 Sec. 30 Twp. 19 R. 1WWell No. 2 LewisF. S. Williams etal

Company

Contractor

FIRST REPORT

C S L SE

Ft. from N. Line

330

Ft. from S. Line

1320

Ft. from E. Line

Ft. from W. Line

RITZ CANTON POOL

SECTION PLAT

Location X

Rig up

Drilling and Remarks:

RECORD

Cased _____ in., _____ ft.

Sand _____

Gas _____

Oil _____

Total Depth _____

PRODUCTION

1st 24 hrs. Nat. _____

1st 24 hrs. after shot _____

Gas _____ Cu. Ft.

Dry Hole _____

Abandoned _____

Date

SEP 27 1939₁₉

S. J. _____

Scout

McPherson **KANSAS**Map No. 43 Sec. 30 Twp. 19 R. 1WWell No. 2 LewisF. S. Williams et al Company

Contractor

COMPLETED**C S L SE****SECTION PLAT**

 Ft. from N. Line330 Ft. from S. Line1320 Ft. from E. Line Ft. from W. Line**RITZ CANTON POOL**Location Rig up

Drilling and Remarks:

*Chas 2935-**5" @ 2944**1000 @ 2956**Pump 179886***RECORD**Cased in., ft.Sand Gas Oil Total Depth 2990**PRODUCTION**1st 24 hrs. Nat. 1st 24 hrs. after shot Gas Cu. Ft.Dry Hole Abandoned

Date

FEB 1 1940 19 S. J. LEWIS Scout