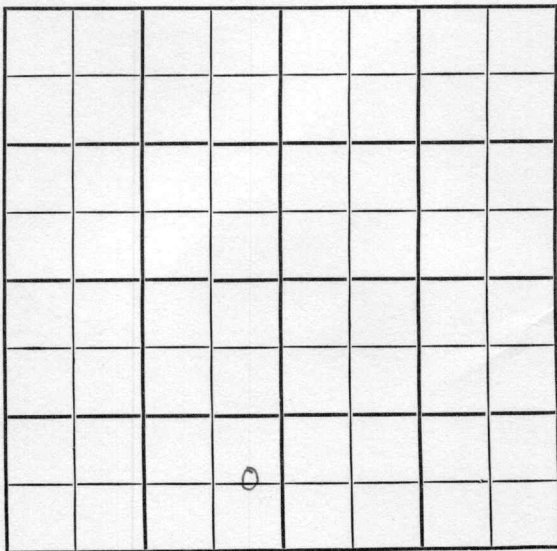


Section 33 Township 31 Range 3EWell No. 3 WilsonCompany Kathel-Emmerich

NORTH

WEST

EAST



SOUTH

Cowley

KANSAS

SEC.	33	TWP.	31	R.	3E
------	----	------	----	----	----

WELL NO.

#3 Wilson

FARM

COMPANY

Kathol-Emmerich

CONTRACTOR

Ft. from N. Line

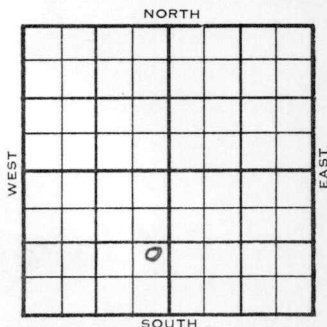
650

Ft. from S. Line

200

Ft. from E. Line

Ft. from W. Line

C E $\frac{1}{2}$ SE SW

FIRST REPORT

1955

ELEVATION

REPORT

7/13

Comm: 7-10-55

8 5/8", @105/100 Drlg. 1600

8/3

TD 2493

DD 2498 100 M-A frac S/

15 boph 2 hr. 15% wtr. Comp. 25 bopd.

Hoover: 1807

Tr. Stal

2053

Dg. Lay

2487

TD.

2493

COMPLETED

County Cowley Elev. _____ Co.
 Sec. 33 Twp. 31 Rge. 3E
 Company Kathol-Emmerich
 Farm Name Wilson No. 3

TOPS

DEPTH

LOG

DATUM

Loc. in Sec. _____

Anh.

Tp.

H.

Tr.

Dg.

Bl.

L.

K.C.

B.K.C.

Ce.

C.

M.

M.

K.

Mz.

Mq.

V.

S.

S.

A.

R.

P.E.

G.

T.D.

C E $\frac{1}{2}$ SE SW

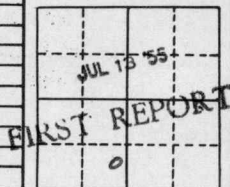
650' SL

200' EL

Geol. _____

Contr. _____

Pool _____

Date Comm. 7-10-558 5/8" @ 105/100 drlg. 1600

Co.

Lse.

No.

Sec.

T.

R.

County Cowley Elev. _____
 Sec. 33 Twp. 31 Rge. 3E
 Company Kathol-Emmerich
 Farm Name Wilson No. 3

TOPS	DEPTH	LOG	DATUM	Loc. in Sec.
Anh.				C E $\frac{1}{2}$ SE SW
Tr.				650' SL
H. <u>ooyer</u>	<u>1807</u>			200' EL
Tr. <u>stal</u>	<u>2053</u>			
Dg. <u>Lay</u>	<u>2487</u>			
BL.				
L.				Geol.
K.C.				Contr.
B.K.C.				
Ce.				
C.				
M.				Pool
M.				
K.				
Mz.				
Mq.				
V.				
S.				
S.				
A.				
R.				
PE.				
G.				
TD.	<u>2493</u>			



Date Comm. 7-10-55 AUG 3 1955
8 5/8" @ 105/100 TD 2493 DD 2498
100 M-A frac S/ 15 boph 2 hr.
15% wtr. Comp. 25 bopd