


Cowley

KANSAS

Section 33 Township 31 Range 3-E

Well No. 5 Wilson

Company Lloyd, Frost & Study

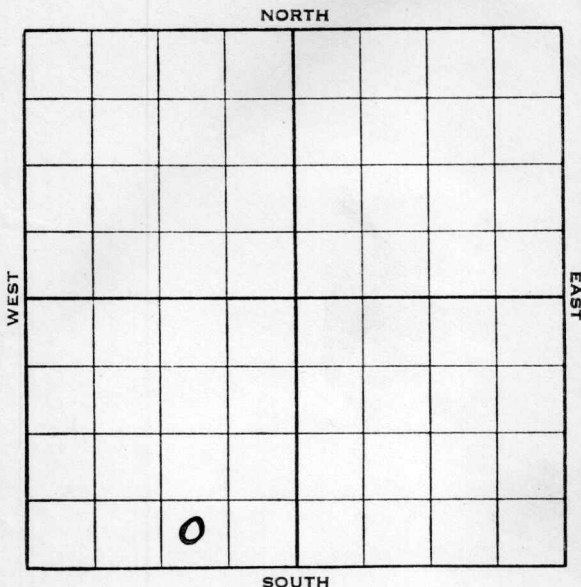

KANSAS


Cowley

Sec. 33 Twp. 31 R. 3-EWell No. #5 Wilson FarmLloyd, Frost & Study Company

_____ Ft. from N. Line

330 Ft. from S. Line990 Ft. from E. Line

_____ Ft. from W. Line

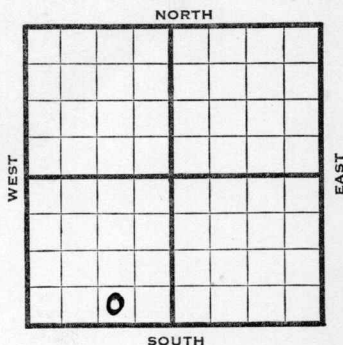

Elev. 1185

1938	REPORT
8/24	R U R
9/2	12" - 84'. Dlg. 1890'.
9/9	K. C. 2505'. Miss. 2985'.
	Dlg. 3002'.
9/16	Arb. 3205-10'. 7" - 3185'.
	Dlg. plug.
9/21	7" at 3185'.
	Arb. 3205'.
	Pay 3221-26'.
	T. D. 3226'.
	1000 acid.
	Flow 1050 bbls. 4 hrs. & 994 bbls
	4 hours.
	Potential 5964 bbls.
	COMPLETED

Cowley

KANSAS

Map No. ✓ Sec. 33 Twp. 31 R. 3EWell No. 5 WilsonLloyd, Frost & Study Company

Contractor

FIRST REPORT

SW SE SW

 Ft. from N. Line330 Ft. from S. Line990 Ft. from E. Line Ft. from W. Line

SECTION PLAT

Location Rig up

Drilling and Remarks:

RUR

RECORD

Cased in., ft.Sand Gas Oil Total Depth

PRODUCTION

1st 24 hrs. Nat. 1st 24 hrs. after shot Gas Cu. Ft.Dry Hole Abandoned

Date

AUG 24 1938

19

H. D. Hatfield Scout

Map No. 1 Sec. 33 Twp. 31 R. 3EWell No. 5 WilsonLloyd, Frost & Study Company

Contractor

SECTION PLAT

SW SE SW

 Ft. from N. Line330 Ft. from S. Line990 Ft. from E. Line Ft. from W. Line

	0		

Location Rig up

Drilling and Remarks:

Pay 3221-26
1000 and

Flow 1050/4 + 994/4

POT 5964

RECORD

Cased 7 in., 3185 ft.Sand ARB 3205Gas Oil Total Depth 3226

PRODUCTION

1st 24 hrs. Nat. 1st 24 hrs. after shot Gas Cu. Ft.Dry Hole Abandoned

Date

SEP 21 1938

19

Scout

Katfield
By: Paul