


McPherson

Form 51-5M-5-34-Palace

Map No. **KANSAS** Sec. 30 Twp. 19 R. 1W

Well No. 5 Garrett Farm
Phillips Pet. Company

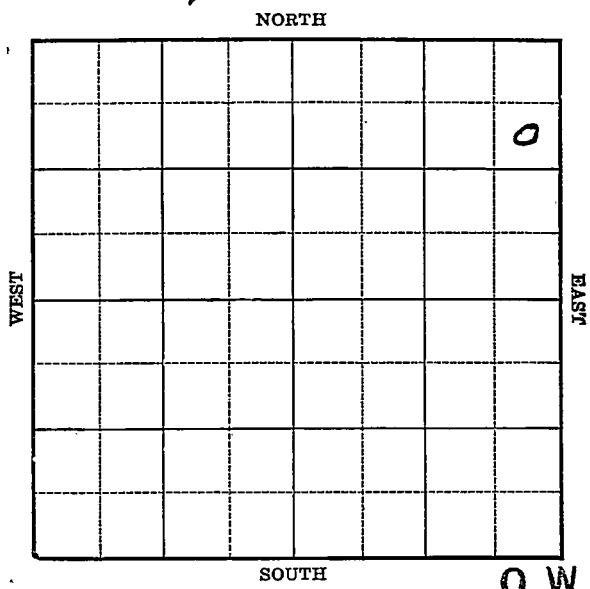

O. W. D. D

Location _____
Drilling Remarks _____

Rig Up _____
Drilling Remarks _____

RECORD

Cased _____ in. _____ ft.
Sand _____
Gas _____
Oil _____
Total Depth _____

PRODUCTION

1st 24 hrs. Nat. _____
1st 24 hrs. after shot _____
Gas _____ cu. ft. _____
Dry Hole _____
Abandoned _____

McPherson

Map No. KANSAS Sec. 30 Twp 19 R. 1W

Well No. 5 Garrett Farm


Phillips Pat. Company

990 Ft. from N. Line

 Ft. from S. Line

330 Ft. from E. Line

 Ft. from W. Line

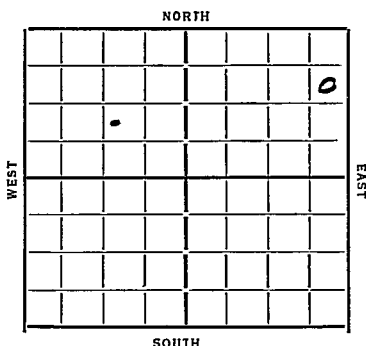

Date 1934

REPORT

O. W. D. D

6/13

Rig

6/21

Rig Rotary

6/28

Alg 800 15 1/2 236

7/5

" 1897

7/12

" 2794 KC 2297

7/19

G. Chat 2939 Alg 3208

7/26

8" 3410 Rust

8/2

T Viola 3415 TD 3419 (2nd)

100' oil

8/8

Viola 3415 TD 3419

1000 acid 157 Bbls.

COMPLETED

O. W. D. D

1937

2/10

5" @ 3523'.

T. D. 3552'.

Water disposal well.

Will take 30 bbls. water per hr.
dy gravity.

FIRST REPORTS

and

ABANDONED

McPherson
Form 26—1M Bks.—2-29

KANSAS

Map No. 43 Sec. 30 Twp. 19 R. 1W

Well No. 5- Harrett

Phillips Pet Company

Contractor

FIRST REPORT

990 Ft. from N. Line

_____ Ft. from S. Line

330 Ft. from E. Line

_____ Ft. from W. Line

SECTION PLAT

			☒

Location _____

Rig up _____

Drilling and Remarks:

Rig

RECORD

Cased _____ in., _____ ft.

Sand _____

Gas _____

Oil _____

Total Depth _____

PRODUCTION

1st 24 hrs. Nat. _____

1st 24 hrs. after shot _____

Gas _____ Cu. Ft.

Dry Hole _____

Abandoned _____

Date

6-13-34 19

ORVAL MANNSCHRECK

Scout

McPherson

Form 28-1M/Bks. 2-29

KANSAS

Map No. 43 Sec. 30 Twp. 19 R. 1W

Well No. 5-Garrett

Phillips pet Company

Contractor

COMPLETED

SECTION PLAT

990 Ft. from N. Line

_____ Ft. from S. Line

330 Ft. from E. Line

_____ Ft. from W. Line

			0

Location _____

Rig up _____

Drilling and Remarks:

1000 and

157 bbls

RECORD

Cased _____ in., _____ ft.

Sand Viola 3415

Gas _____

Oil _____

Total Depth 3419

PRODUCTION

1st 24 hrs. Nat. _____

1st 24 hrs. after shot _____

Gas _____ Cu. Ft.

Dry Hole _____

Abandoned _____

Date

8-8-34 19

ORVAL MANNSCHRECK

Scout

M. E. Blum
Form 26 - 1-1-1933

KANSAS

Map No. 43 Sec. 20 Twp. 19 R. 1W

Well No. 5 Garrett

Phillips Pet. Company

Contractor

SECTION PLAT

			0

99 Ft. from N. Line

_____ Ft. from S. Line

330 Ft. from E. Line


COMPLETED

OWD

Location _____

Rig up _____

Drilling and Remarks:

5" @ 35-23

will take 30 88 1/2

water per hr. by

gravity

Water Disposal

Well

RECORD

Cased _____ in., _____ ft.

Sand _____

Gas _____

Oil _____

Total Depth 3552

PRODUCTION

1st 24 hrs. Nat. _____

1st 24 hrs. after shot _____

Gas _____ Cu. Ft.

Dry Hole _____

Abandoned _____

Date

FEB 10 1937 19

S. J. LEWIS Scout