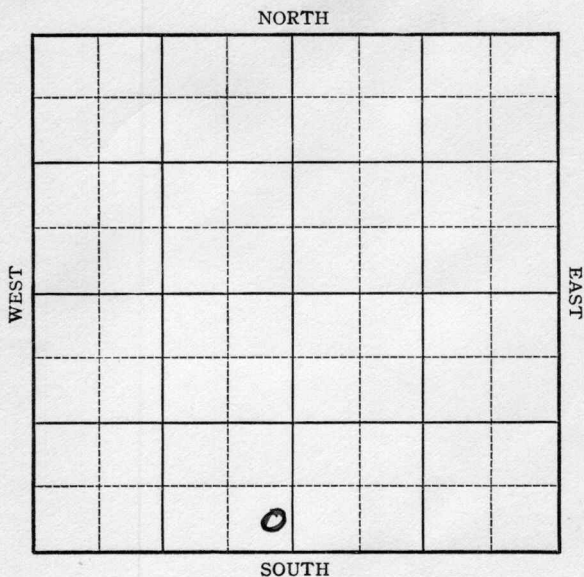


Section 33 Township 31 Range 3-EWell No. 1 - K - Wilson Twin #4Company Lloyd, Frost & Stucy

KANSAS

Map No. 1 Sec. 33 Twp. 31 R. 3EWell No. 1-K, - Wilson Twin
#4Lloyd, Frost & Study Company

FIRST REPORT

Contractor

(K.C. Lime Test)

SECTION PLAT

 Ft. from N. Line330 Ft. from S. Line280 Ft. from E. Line Ft. from W. LineLocation Rig up

Drilling and Remarks:

R.R.

RECORD

Cased in., ft.Sand Gas Oil Total Depth

PRODUCTION

1st 24 hrs. Nat. 1st 24 hrs. after shot Gas Cu. Ft.Dry Hole Abandoned

Date

SEP 15 1937
19H. D. Hatfield Scout

Cowley

KANSAS

Map No. 1 Sec. 33 Twp. 31 R. 3EWell No. 1-K-Wilson (Twin #4)Lloyd Frost & Study Company

Contractor

ABANDONED
SE SW

SECTION PLAT

01

 Ft. from N. Line330 Ft. from S. Line280 Ft. from E. Line Ft. from W. LineLocation Rig up

Drilling and Remarks:

P-7 bbls oil / 4LOTS OF WATER18 hrsD & A

RECORD

Cased in., ft.Sand K.C. 2458Gas Layton 2477Oil Total Depth 2604

PRODUCTION

1st 24 hrs. Nat. 1st 24 hrs. after shot Gas Cu. Ft.Dry Hole Abandoned

Date

OCT 27 1937

19

H. D. Hatfield

Scout