


Section 31 Township 19 Range 1-W
Well No. 1 Lagree
Company H. & M. Drlg.

NORTH Ritz-Canton Pool

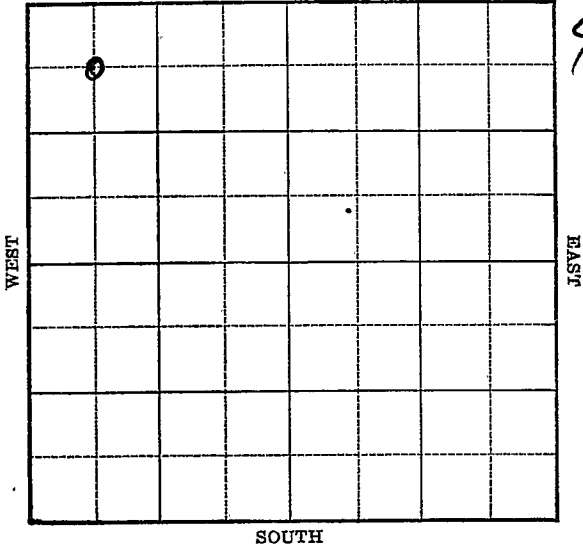

KANSAS

McPherson

Sec. 31 Twp. 19 R. 1-WWell No. #1 Lagreë Farm


H & M Drlg.

Company

(Ritz-Canton)

650 Ft. from N. Line Ft. from S. Line Ft. from E. Line660 Ft. from W. Line

Elev. 1564

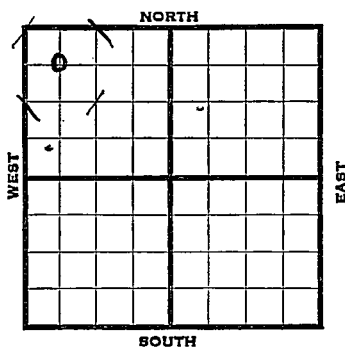

1939	REPORT
2/1	Cellar.
2/10	Spud.
2/17	15" - 85' Drlg. 570
2/23	" " " "
3/3	Drlg. 1500'
3/10	12" - 885' 10" - 1770'
	Drlg. 2200'
3/17	8" - 2204' Drlg. 2510'
3/24	Lans. 2295' T. D. 2878'
	Rng. 7".
3/31	Chat. 2916' T. D. 2938'
	7" - 2938'
4/7	Pay 2955' Drlg. 2965'
	1500' oil.
4/14	T.D. 2767' Swab 10' oil per hr.
	3000 acid.
	OVER

1939

4/19

7" - 2938'

Chat. 2916'

T. D. 2967'

3000 acid.

Pump & flow 206 bbls. 8 hours.

Potential 626 bbls.

COMPLETED

McPherson

KANSAS

Map No. 43 Sec. 31 Twp. 19 R. 1WWell No. 1 Lagree

H & M Drlg.

Company

Contractor

FIRST REPORT

C NW NW

650 Ft. from N. Line Ft. from S. Line Ft. from E. Line660 Ft. from W. Line

RITZ-CANTON POOL

SECTION PLAT

0			
well in NW/4			
has been plugged			

Location Rig up Drilling and Remarks:
Cellar

RECORD

Cased in., ft.Sand Gas Oil Total Depth

PRODUCTION

1st 24 hrs. Nat. 1st 24 hrs. after shot Gas Cu. Ft.Dry Hole Abandoned

Date

FEB. 1 - 1939

19

H. D. Hatfield Scout

McPherson KANSAS

Map No. 43 Sec. 31 Twp. 19 R. 1WWell No. 1 LagreeH & M Drilling Company

Contractor

COMPLETED

SECTION PLAT

650 C NW NW
Ft. from N. Line

Ft. from S. Line

Ft. from E. Line

660 Ft. from W. Line

0			

RITZ CANTON POOL

Location

Rig up

Drilling and Remarks:

3000 Acid
PTF 2068
Pot 626

RECORD

Cased 7 in., 2938 ft.Sand Chat 2916

Gas

Oil

Total Depth 2967

PRODUCTION

1st 24 hrs. Nat.

1st 24 hrs. after shot

Gas Cu. Ft.

Dry Hole

Abandoned

Date

APR 19 1939 19

H. D. Hatfield Scout