


Section 36 Township 31 Range 3 E

Well No. #1 Schwintz

Company Time Petroleum

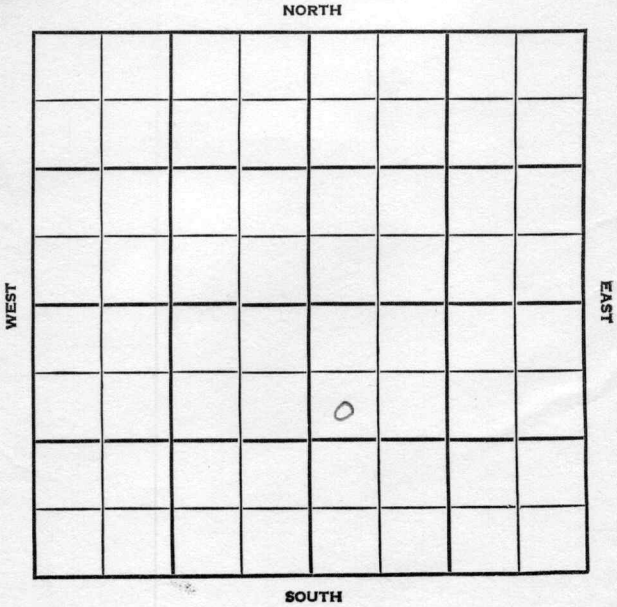

Cowley

KANSAS

SEC. 36	TWP. 31	R. 3E
------------	------------	----------

WELL NO.

#1 Schwintz

FARM

COMPANY

Time Petr.

CONTRACTOR

Kirkpatrick


WILDCAT

_____ Ft. from N. Line

_____ Ft. from S. Line

_____ Ft. from E. Line

_____ Ft. from W. Line

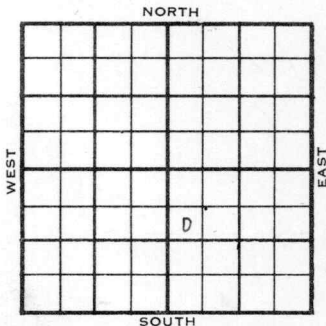

SW NW SE

1956	ELEVATION	REPORT
------	-----------	--------

2-1 MIR

County Cowley Elev. _____
 Sec. 36 Twp. 31 Rge. 3E
 Company Time Petroleum
 Farm Name Schwintz No. 1

TOPS	DEPTH	LOG	DATUM	Loc. in Sec.
Anh.				SW NW SE
TP.				
H.				
Tr.				
Dg.				
B.L.				
L.				
K.C.				Geol. _____
B.K.C.				Contr. _____
Ce.				Kirkpatrick
C.				
M.				Pool _____
M.				Wildcat
K.				
Mz.				
Ma.				
V.				
S.				
S.				
A.				
R.				
Pe.				
G.				
T.D.				

FIRST REPORT		
FEB 1 56		

Date Comm. MIR

Co.
Lse.
No.
Sec.
T.
R.

County Cowley Elev. 1134
 Sec. 36 Twp. 31 Rge. 3E
 Company Time Petroleum
 Farm Name Schwintz No. 1

	TOPS	DEPTH	LOG	DATUM
Arh.				
Tp.	<u>Stall.</u>	<u>2004-2105</u>		
H.	<u>Lay</u>	<u>2428</u>		
Tr.				
Dg.				
Bl.				
L.				
K.C.		<u>2491</u>		<u>1307</u>
B.K.C.				<u>1646</u>
Co.	<u>FT 30T</u>	<u>2780</u>		<u>1722</u>
G.	<u>CE</u>	<u>2856</u>		<u>1876</u>
M.		<u>3010</u>		
M.				
K.				
M.				
Mo.				
V.				
S.				
S.				
A.		<u>3365</u>		<u>2231</u>
R.				
PE				
G.				
TA		<u>3394</u>		

Loc. in Sec. SW NW SE
 Geol. _____
 Contr. Kirkpatrick
 Pool Wildcat

ABANDONED

Date Comm. FEB 15 1956
MIR FEB 8 '56 2-1-56 8⁵/₈ 103110
2628 FEB 15 '56

W.E.A.

Co.
 No.
 Sect.
 T.
 R.