


Cowley  
31 R. 4E

Map No. KANSAS Sec. 2 Twp. \_\_\_\_\_ R. \_\_\_\_\_

Well No. 1 - David Wichefield Farm \_\_\_\_\_ Company \_\_\_\_\_

NORTH

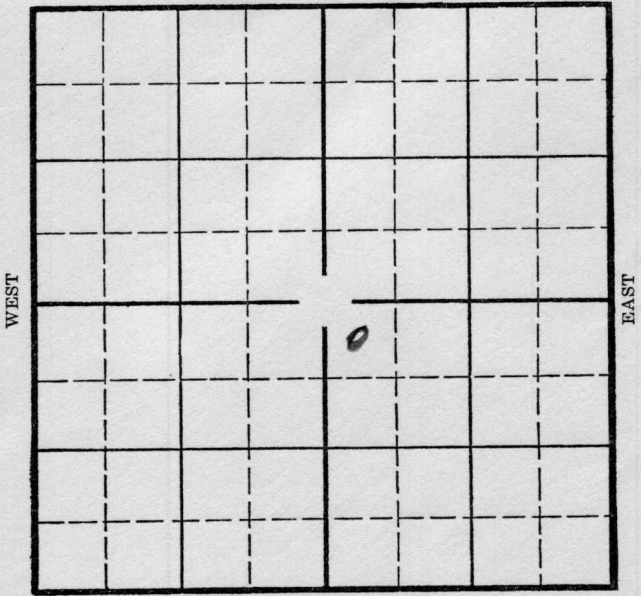

SOUTH

Location \_\_\_\_\_  
Drilling Remarks \_\_\_\_\_

Rig Up \_\_\_\_\_  
Drilling Remarks \_\_\_\_\_

\_\_\_\_\_  
 \_\_\_\_\_  
RECORD

PRODUCTION

Cased \_\_\_\_\_ in. \_\_\_\_\_ ft.  
 Sand \_\_\_\_\_  
 Gas \_\_\_\_\_  
 Oil \_\_\_\_\_  
 Total Depth \_\_\_\_\_

1st 24 hrs. Nat. \_\_\_\_\_  
 1st 24 hrs. after shot \_\_\_\_\_  
 Gas \_\_\_\_\_ cu. ft. \_\_\_\_\_  
 Dry Hole \_\_\_\_\_  
 Abandoned \_\_\_\_\_

Cowley 4E

Map No. KANSAS Sec. 2 Twp. 31 R. 4E

Well No. 1 - David Farm \_\_\_\_\_

Wakefield


Company \_\_\_\_\_

330 Ft. from N. Line

\_\_\_\_\_ Ft. from S. Line

\_\_\_\_\_ Ft. from E. Line

330 Ft. from W. Line

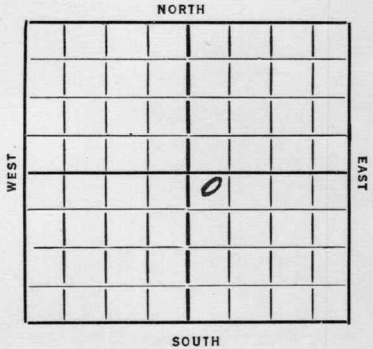

REPORT

| Date  | Location                    |          |
|-------|-----------------------------|----------|
| 12/11 | Location                    |          |
| 12/19 | Pits & Material             |          |
| 12/26 | —                           |          |
| 12/36 | Ru                          |          |
| 1/10  | Sly 785                     | 15" 485  |
| 1/17  | " 1605                      | 12" 990  |
| 1/24  | 10" 1633 TD 1945 WR 10"     |          |
| 1/31  | Sly 2040                    | 10" 1950 |
| 2/7   | 8" 2050 6" 2525 TD WOC      |          |
| 2/14  | Sly 2930                    |          |
| 2/21  | Barthoville 2958-82         |          |
|       | 5" 2951 to 2958-615 2973-78 |          |
|       | Swabbed 10 Bbls 3 1/2 hrs   |          |
|       | TD 2984 1000' Oil Co        |          |
| 2/28  | On Pot                      |          |
| 3/4   | Sand 2958 TD 2978           |          |
|       | 134 Bbls.                   |          |

COMPLETED



KANSAS

Map No. 2 Sec. 2 Twp. 31 R. 4E

Well No. 1-David

Wakefield Company

Contractor

COMPLETE

SECTION PLAT

330 Ft. from N. Line  
..... Ft. from S. Line  
..... Ft. from E. Line  
330 Ft. from W. Line

|  |  |   |  |
|--|--|---|--|
|  |  |   |  |
|  |  |   |  |
|  |  | 0 |  |
|  |  |   |  |
|  |  |   |  |

Location.....  
Rig up.....  
Drilling and Remarks:

134 bbls

RECORD

Cased..... in., ..... ft.  
Sand 2958  
Gas.....  
Oil.....  
Total Depth 2978

PRODUCTION

1st 24 hrs. Nat.....  
1st 24 hrs. after shot.....  
Gas..... Cu. Ft.  
Dry Hole.....  
Abandoned.....

Date

3-4-36 192.....

ORVAL MANNSCHRECK

Scout