


Section 2 Township 31 Range 4-E

Well Number 4-David

Company Derby Oil

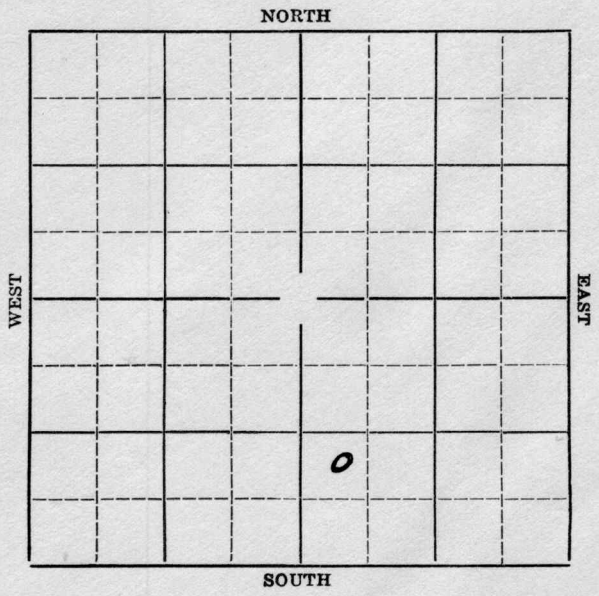

Map No. **KANSAS** Sec. **2** Twp. **31** R. **4E**


Well No. **#4 David** Farm  
**Derby Oil** Company

\_\_\_\_\_ Ft. from N. Line

**990'** Ft. from S. Line

\_\_\_\_\_ Ft. from E. Line

**330'** Ft. from W. Line

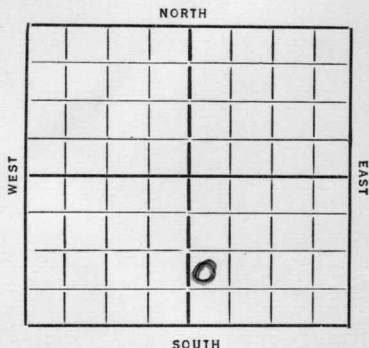

Date  
**1936**

REPORT

**6/10 10" @ 75'. Waiting on cement.**

**6/18 Drlg. 1640'.**

**6/25 Drlg. 2751'.**

**7/2 Bart. 2947'. T.D. 2950'. RUST.**

**7/9 T.D. 2967'. 125' oil in 1 hours.**

**7/16 Shot 10 & 25 qts. Swab 1 1/4 bbls of oil per hour.**

**7/22/36-Bart. sand 2947'.**

**T.D. 2967'.**

**Shot 10 & 25 qts.**

**60 bbls of oil potential.**

**COMPLETED**

Map No. 2 Sec. 2 Twp. 31 R. 4E

Well No. 4 David

Terby Oil Company

Contractor

SECTION PLAT

		o	

\_\_\_\_\_ Ft. from N. Line

990 Ft. from S. Line

\_\_\_\_\_ Ft. from E. Line

330 Ft. from W. Line

FIRST REPORT

Location \_\_\_\_\_

Rig up \_\_\_\_\_

Drilling and Remarks:

10" @ 75' WOC.

RECORD

Cased \_\_\_\_\_ in., \_\_\_\_\_ ft.

Sand \_\_\_\_\_

Gas \_\_\_\_\_

Oil \_\_\_\_\_

Total Depth \_\_\_\_\_

PRODUCTION

1st 24 hrs. Nat. \_\_\_\_\_

1st 24 hrs. after shot \_\_\_\_\_

Gas \_\_\_\_\_ Cu. Ft.

Dry Hole \_\_\_\_\_

Abandoned \_\_\_\_\_

Date

JUN 10 1936 19

S. J. LEWIS Scout

Map No. 2 Sec. 2 Twp. 31 R. 4E

Well No. 4 David

Deeby Oil Company

Contractor

SECTION PLAT

		o	

\_\_\_\_\_ Ft. from N. Line

990 Ft. from S. Line

\_\_\_\_\_ Ft. from E. Line

330 Ft. from W. Line

COMPLETED

Location \_\_\_\_\_

Rig up \_\_\_\_\_

Drilling and Remarks:

Bar. Sel 2947.

Blw 8 10 x 25 9 1/2

Por 60 4 1/2

RECORD

Cased \_\_\_\_\_ in., \_\_\_\_\_ ft.

Sand \_\_\_\_\_

Gas \_\_\_\_\_

Oil \_\_\_\_\_

Total Depth 2967

PRODUCTION

1st 24 hrs. Nat. \_\_\_\_\_

1st 24 hrs. after shot \_\_\_\_\_

Gas \_\_\_\_\_ Cu. Ft.

Dry Hole \_\_\_\_\_

Abandoned \_\_\_\_\_

Date

JUL 22 1936 19

S. J. LEWIS Scout