

Kansas

Map No. _____ Sec. 23 Twp. 27 R. 6

Well No. 1 Brock Farm _____

White Eagle Company _____

NORTH

WEST

EAST

SOUTH

FIRST REPORT

Location _____

Rig Up _____

Drilling Remarks:

Drilling Remarks:

RECORD

PRODUCTION

Cased _____ in. _____ ft.

1st 24 hrs. Nat. _____

Sand _____

1st 24 hrs. after shot _____

Gas _____

Gas _____ cu. ft.

Oil _____

Dry Hole _____

Total Depth _____

Abandoned _____

Map No. K Sec. 23 Twp. 27 R. 6


Well No. 1 Brock Farm
White Eagle Company

200 Ft. from N. Line

_____ Ft. from S. Line

1120 Ft. from E. Line

_____ Ft. from W. Line

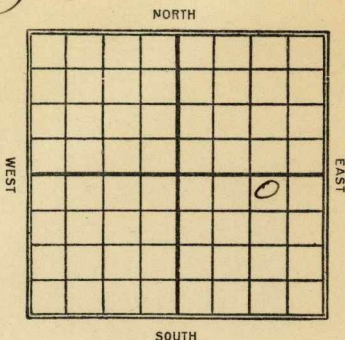

Date

REPORT

1922
11/24 Timbers.

1923
6/23 D + A - 2790'

Map No. KANSAS Sec. 23 Twp. 27 R. 6Well No. 1 BrackWhite Eagle Company

Contractor

FIRST REPORT

SECTION PLAT

200 Ft. from N. Line

Ft. from S. Line

1120 Ft. from E. Line

Ft. from W. Line

			0

Location

Rig up

Drilling and Remarks:

Timbers

RECORD

Cased _____ in., _____ ft.

Sand _____

Gas _____

Oil _____

Total Depth _____

PRODUCTION

1st 24 hrs. Nat. _____

1st 24 hrs. after shot _____

Gas _____ Cu. Ft.

Dry Hole _____

Abandoned _____

Date

NOV 24 1922

M. A. BENEAR

Scout

Map No. **KANSAS** 11 23 Sec. 27 Twp. 27 R. 6

Well No. 1 Brook

White Eagle Company

Contractor

ABANDONED SECTION PLAT

200 Ft. from N. Line

Ft. from S. Line

1120 Ft. from E. Line

Ft. from W. Line

			0

Location

Rig up

Drilling and Remarks:

LOT 9

2790

RECORD

Cased _____ in., _____ ft.

Sand _____

Gas _____

Oil _____

Total Depth _____

PRODUCTION

1st 24 hrs. Nat. _____

1st 24 hrs. after shot _____

Gas _____ Cu. Ft.

Dry Hole _____

Abandoned _____

Date

JUN 23 1923

M. A. BENEAR

Scout