


Section 2 Township 31 Range 4-E

Well No. #2 David

Company Derby

NORTH Miscellaneous

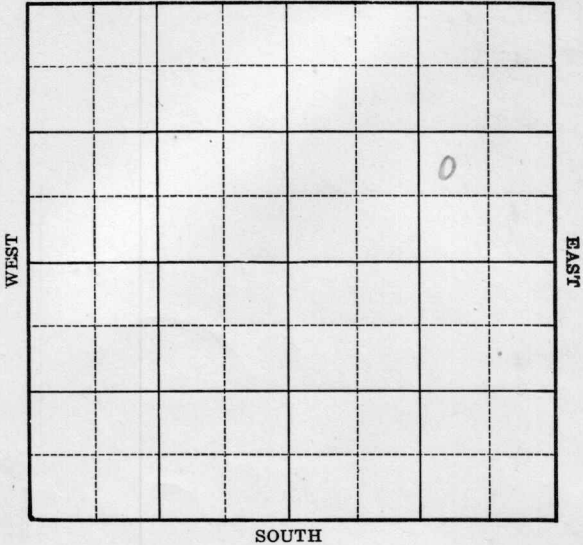

Sec. 2 Twp. 31 R. 4-E

Well No. #2 David Farm _____
Derby Company _____


(Misc.)

_____ Ft. from N. Line

990 Ft. from S. Line

990 Ft. from E. Line

_____ Ft. from W. Line

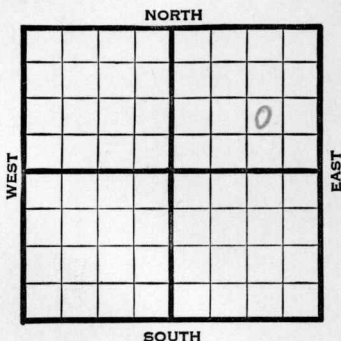

Elev. ~~1294~~ 1287

1940

REPORT

11/7 Rotary.

11/14 8" - 122' Drlg. 1535'

11/21 Drlg. 2725'

11/27 K.C. 2350' Bart. 2950-51' T.D.

5" - 2950' C.O.

12/4 Bart. 2950' B. Bart. 2969'

5" - 2950'

T.D. 2972'

Shot 39 qts. 2955-70'

Pump 60 bbls. 42. Gravity

COMPLETED

Map No. 2 Sec. 2 Twp. 31 R. 4E

Well No. 2 David
Derby

Company _____

Contractor _____

FIRST REPORT

NW SE NE

_____ Ft. from N. Line

990 Ft. from S. Line

990 Ft. from E. Line

_____ Ft. from W. Line

SECTION PLAT

			o

MISCELLANEOUS

Location _____

Rig up _____

Drilling and Remarks:

Rotary

RECORD

Cased _____ in., _____ ft.

Sand _____

Gas _____

Oil _____

Total Depth _____

PRODUCTION

1st 24 hrs. Nat. _____

1st 24 hrs. after shot _____

Gas _____ Cu. Ft.

Dry Hole _____

Abandoned _____

Date

NOV 6 1940

19

S. J. LEWIS

Scout

