


Section 2 Township 31 Range 4E

Well No. #4 ~~#2~~ David

Company Wakefield

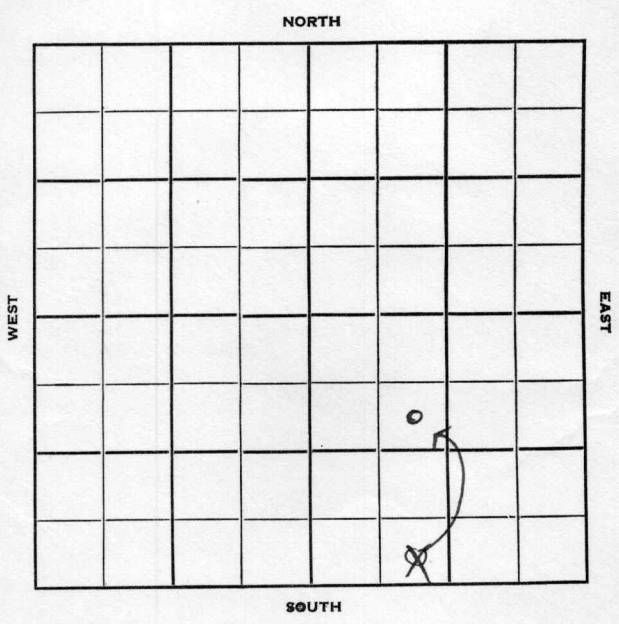

Cowley

KANSAS

Sec. 2 Twp. 31 R. 4E

Well No. ~~#2~~ **#4** David Farm

Wakefield Company

Contractor

David


990 Ft. from N. Line

~~330~~ Ft. from S. Line

Ft. from E. Line

990 Ft. from W. Line

~~SE SW SE~~
SE NW SE

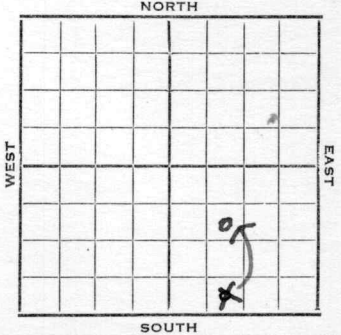

1952 Elev. 1268' REPORT

3/26 Surf set
 5/7 Spud 4-8-52
 Oil Well TD 2954'
 8" @ 94
 Bart. 2937
 5" @ 2938 TD 2954'
 S/ 1/2 boph Hydro
 Comp. 25 bopd

COMPLETED

Map No. _____ Sec. 2 Twp. 31 R. 4E

Well No. 4 David

Wakefield Company

CORRECTION Contractor

SE NW SE

SECTION PLAT

990 Ft. from N. Line

_____ Ft. from S. Line

_____ Ft. from E. Line

990 Ft. from W. Line

Cowley County

Location _____

Rig up _____

Drilling and Remarks:

Reported
#2 David
SE SW SE

RECORD

Cased _____ in., _____ ft.

Sand _____

Gas _____

Oil _____

Total Depth _____

PRODUCTION

1st 24 hrs. Nat. _____

1st 24 hrs. after shot _____

Gas _____ Cu. Ft.

Dry Hole _____

Abandoned _____

Date

J. G. McGEHEE

Scout

