

McPherson

SECTION 31 TOWNSHIP 19 RANGE 1 WWELL NO. #1 UnruhCOMPANY Lindas Oil Inc.

NORTH

9

WEST

EAST

						0	

SOUTH

McPherson

KANSAS

SEC.	31	TWP.	19	R.	1W
------	----	------	----	----	----

WELL NO.

#1 Unruh

FARM

COMPANY

Lindas Oil Inc.

CONTRACTOR

Republic

Rigz-Canton


_____ Ft. from N. Line

_____ Ft. from S. Line

_____ Ft. from E. Line

_____ Ft. from W. Line

SW NE SE

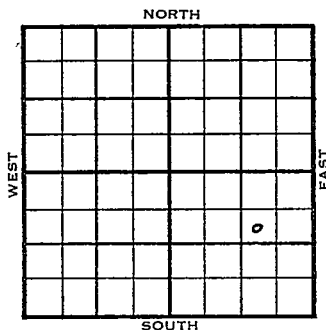

1955

ELEVATION

1577'

REPORT

10/19

Comm 10-11-55

8" @ 155/125

Dr1g 1152

11-16

DST 2950-95 op 1 hr. rec. 250' wh,

120' ocsw 489/20"

DD 3448, wtr. 500

1000 A, S/ 44 bw

D & A

TD 3448'

Tops: Chat 2936

K. 3180

V. 3419.

ABANDONED

County	McPherson	Elev.	
Sec.	31	Twp.	19
Company	Lindas Oil Inc.	Rge.	1W
Farm Name	Unruh	No.	1

TOPS	DEPTH	LOG	DATUM	Loc. in Sec.
Anh.				SW NE SE
Tr.				
H.				
Tr.				
Dg.				
BL.				
L.				Geol.
K.C.				Contr.
B.K.C.				Republic
Ce.				Pool
C.				Ritz-Canton
M.				
M.				
K.				
Mz.				
Ma.				
V.				
S.				
S.				
A.				
R.				
Pe.				
G.				
TD.				

FIRST REPORT

OCT 19 1955

Date Comm. 10-14-55

8" @ 155/125 drlg. 1152

County McPherson Elev. 1577Sec. 37 Twp. 7S Rge. 1WCompany Lindas Oil Inc.Farm Name Unruh No. 1

TOPS	DEPTH	LOG	DATUM	Loc. in Sec.
Anh.				SW NE SE
Tr.				
Dg.				
Bl.				
L.				
K.C.				Geol.
B.K.C.				Contr.
Ce.				Republic
C.				Pool
M. <u>Chat</u>	<u>2936</u>		<u>1359</u>	Ritz-Canton
M.				
K.	<u>3180</u>		<u>1603</u>	
Mz.				
Mq.				
V.	<u>3419</u>		<u>1842</u>	
S.				
S.				
A.				
R.				
Pe.				
G.				
T.D.	<u>3421</u>			

ABANDONED

Date Comm. 10-14-55

NOV 16 1955

8" @ 155/125 DST 2950-95 open 1 hr.

rec. 250' wm 120' ocsw 489/20"

DD 3448 wtr SOO 1000 A S/ 144 w

D & A