


Section 31 Township 19 Range 1-WWell No. 2 LagreeCompany H & M Drlg.

NORTH Ritz Canton Pool

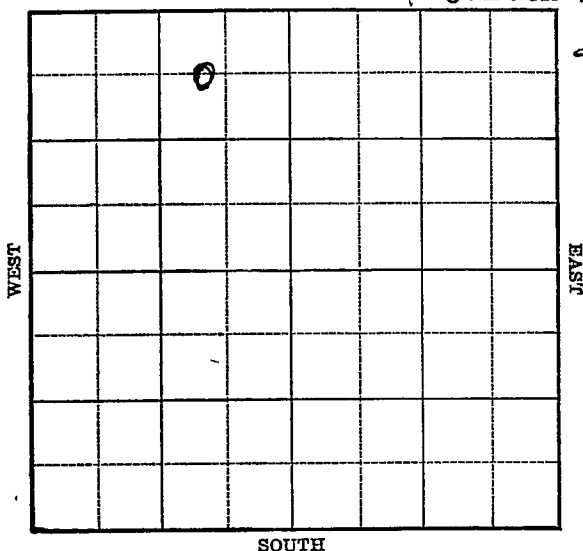

KANSAS


McPherson

Sec. 31 Twp. 19 R. 1-WWell No. #2 Lagree FarmH & M Drlg. Company

(Ritz Canton)

660 Ft. from N. Line Ft. from S. Line980 Ft. from E. Line Ft. from W. Line


Elev. 1565

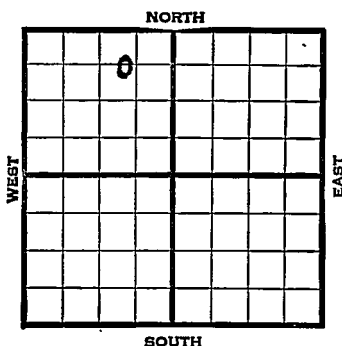

1939	REPORT
5/17	Machine.
5/26	Rigging up.
6/7	Spud.
6/8	S. gas 670' 12 @ 1038'
	Drlg. 1070'
6/16	Drlg. 1415'
6/23	10" - 1649' Drlg. 2122'
6/29	8" - 2270' Drlg. 2610'
7/6	Drlg. 2910'
7/13	Chat. 2915' 6" - 2932'
	Drlg. 2951' No shows.
7/20	Pay 2965' T.D. 2993'
	3000 acid. No test.
7/26	Chat. 2915'
	6" - 2932'
	T.D. 2993'
	3000 acid.
	Potential 299 oil & 3 water on pump.
	COMPLETED

McPherson **KANSAS**Map No. 43 Sec. 31 Twp. 19 R. 1WWell No. 2 LagreeH & M Drlg. Company

Contractor

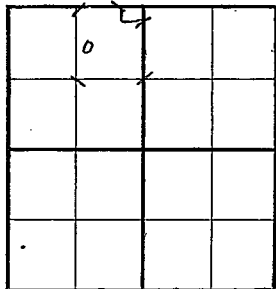FIRST REPORT**C W L NE NW**660 Ft. from N. Line Ft. from S. Line980 Ft. from E. Line Ft. from W. Line**RITZ CANTON POOL****SECTION PLAT**Location Rig up

Drilling and Remarks:

Mach.

**H & M have all
NE/40 Acres, except
NE. 10 acres.**

RECORDCased in., ft.Sand Gas Oil Total Depth **PRODUCTION**1st 24 hrs. Nat. 1st 24 hrs. after shot Gas Cu. Ft.Dry Hole Abandoned

Date

MAY 17 1939 19S. J. LEWIS

Scout

Map No. 43 Sec. 31 Twp. 19 R. 1WWell No. 2 LagreeH & M Drlg.

Company

Contractor

COMPLETED

SECTION PLAT

660 C W L NE NW
Ft. from N. Line

Ft. from S. Line

980 Ft. from E. Line

Ft. from W. Line

RITZ CANTON POOL

Location

RECORD

Rig up

Cased _____ in., _____ ft.

Drilling and Remarks

Sand _____

Gas _____

Chas 82915

Coil _____

*6" @ 2932*Total Depth 2993*8000 acid*

PRODUCTION

1st 24 hrs. Nat. _____

1st 24 hrs. after shot _____

Pump 299 oil

Gas _____ Cu. Ft.

3 Water P. Y.

Dry Hole _____

Abandoned _____

Date

JUL 26 1939 19

S. J. LEWIS

Scout